

RECEIVED
SVBX PDCC
JUNE 27, 2013

P0728-C700-DU-018WP04.RFC.R1

DU-018



SSH JV

UPRR Industrial Lead Bridge Retaining Wall/Sound Wall Design Unit 018 – Work Package 04 RFC Revision 1

SVBX C700



Friday, June 07, 2013

HALF SIZE
COPY



TYLIN INTERNATIONAL
engineers | planners | scientists

B1306-F578

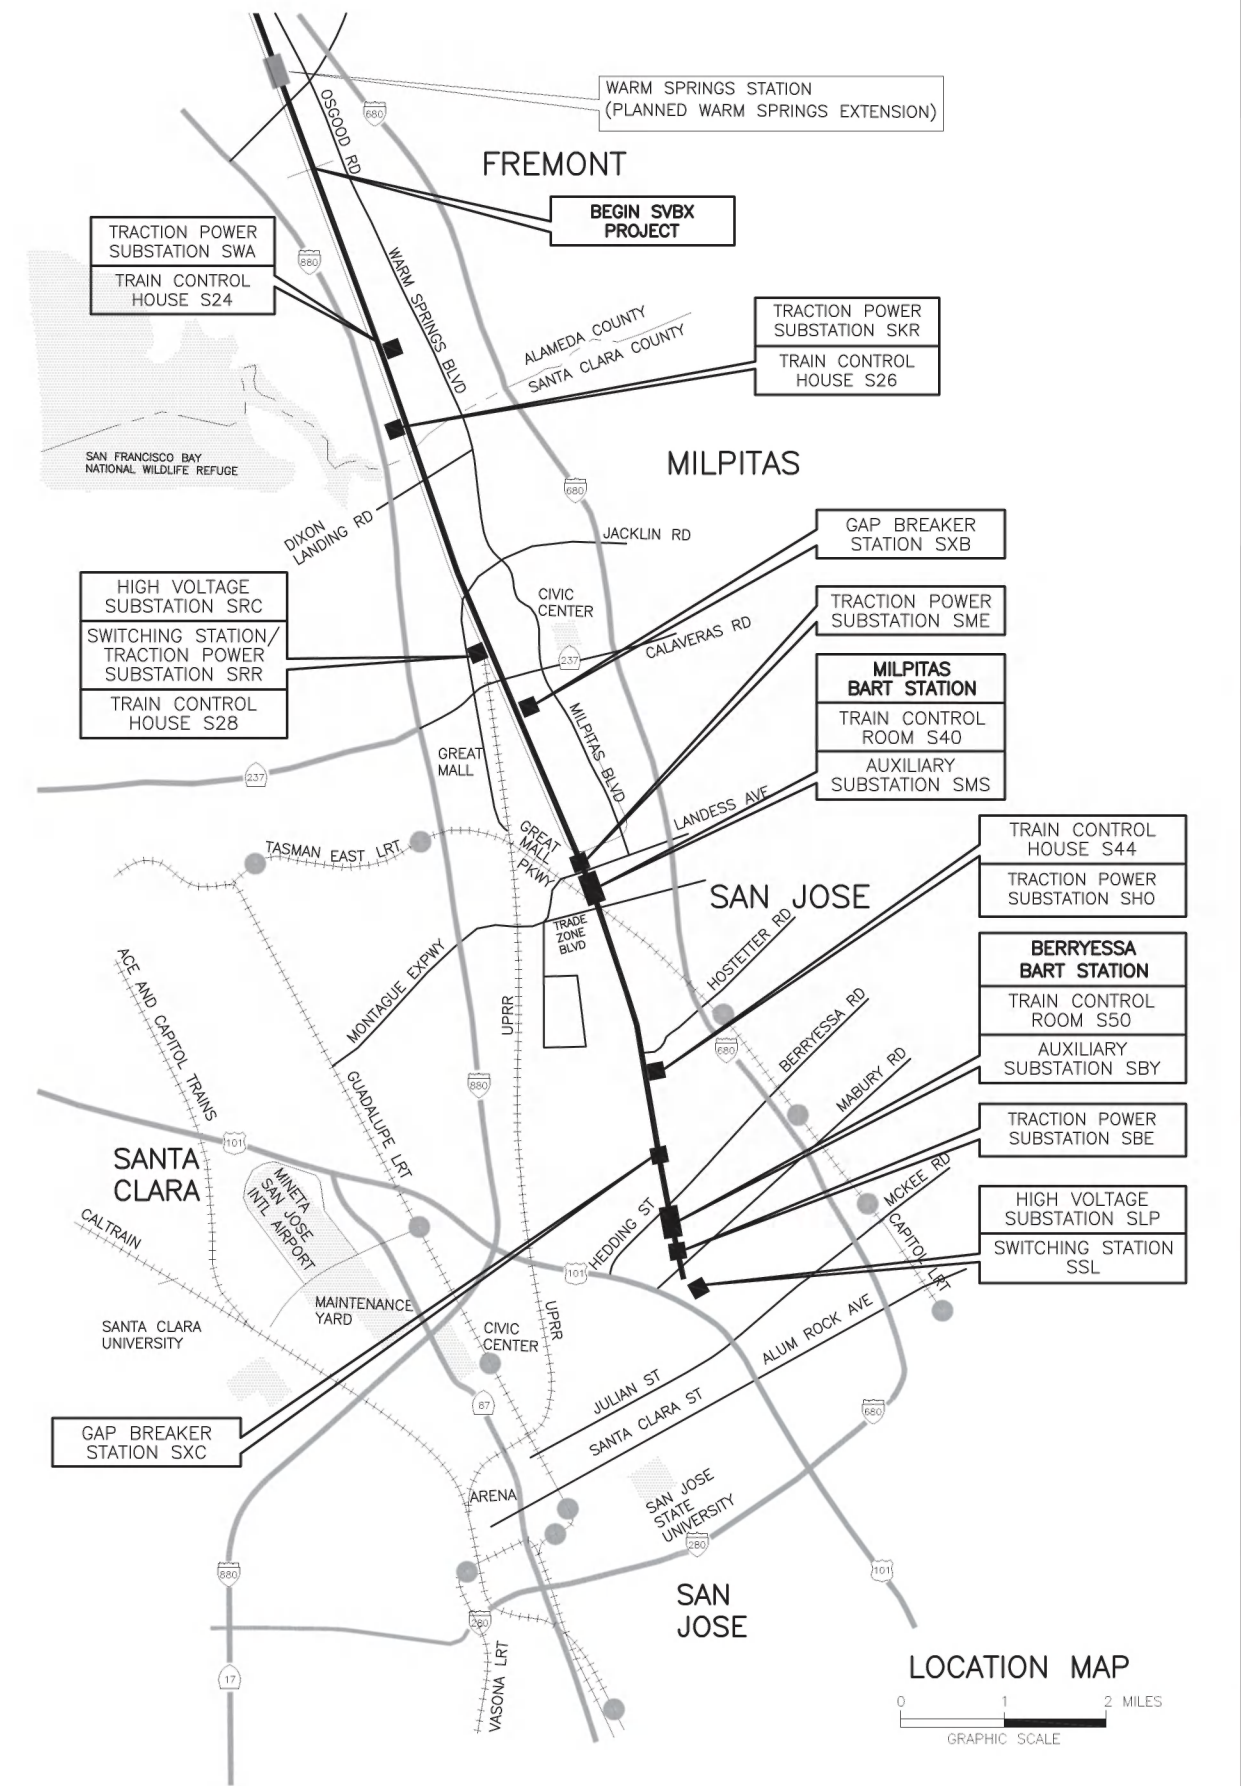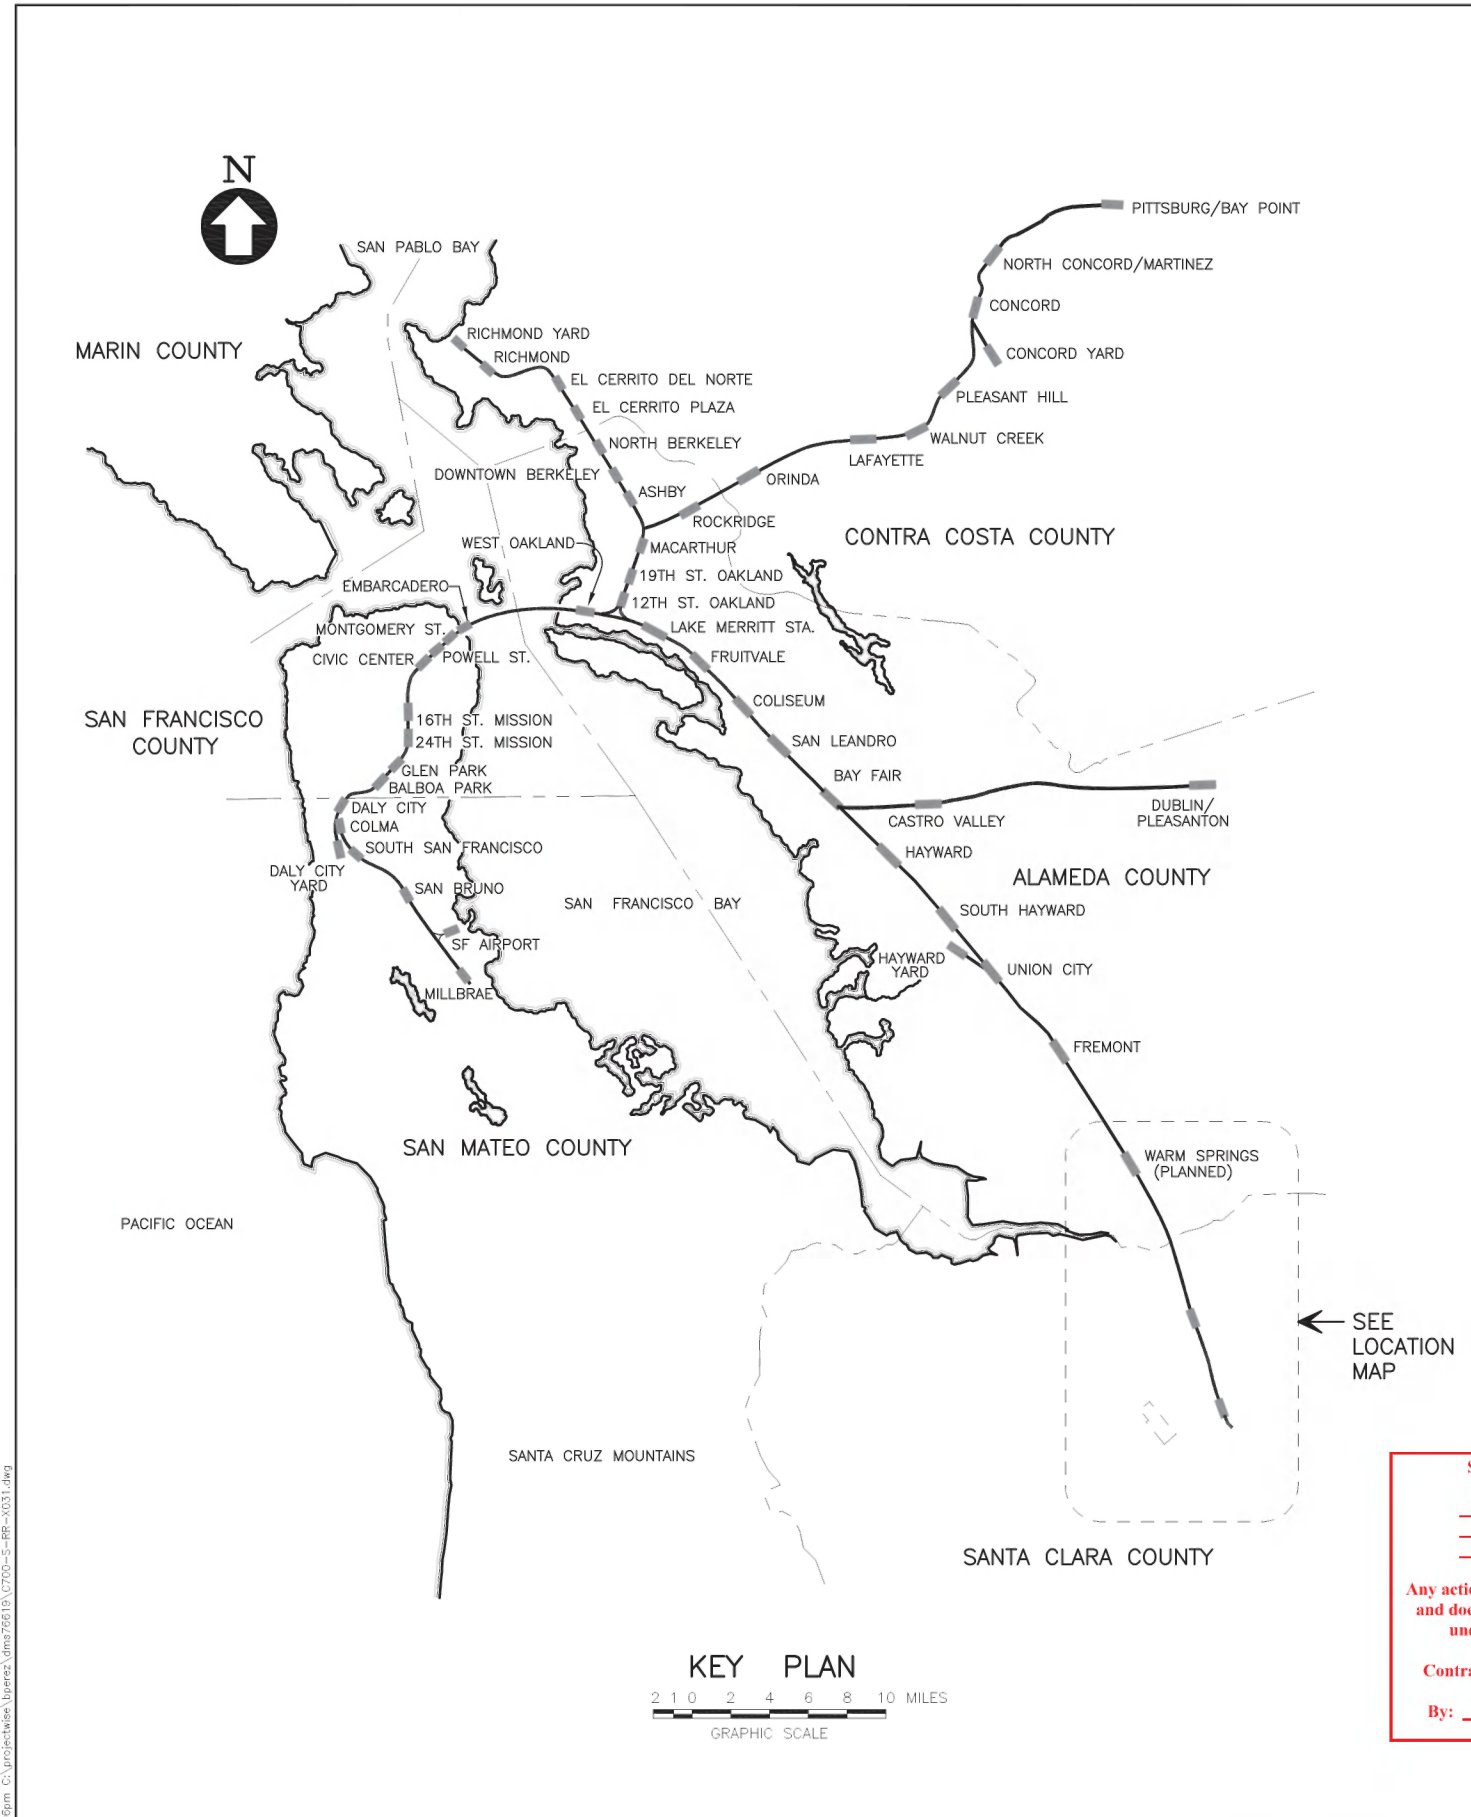

Santa Clara Valley Transportation Authority

☒ NO EXCEPTIONS TAKEN (NET)
☐ MAKE CORRECTIONS NOTED (MCN)
☐ AMEND AND RESUBMIT (A/R)

Any action shown above is subject to the terms of the contract and does not relieve the Contractor of any of its obligations under the contract, including design and detailing.

Contract No.: DB11002F

By: [Signature] Date: 7/1/13

Nov 02, 2012

0

20121102

READY FOR CONSTRUCTION

DESIGNED BY
R. BANKS
DRAWN BY
J. HUMBLE
CHECKED BY
D. CLARY
IN CHARGE
K. ANDERSON

20121102

LOCKWOOD, ANDREWS & NEWNAM, INC.

LOCKWOOD, ANDREWS & NEWNAM, INC.

LOCKWOOD, ANDREWS &

Nov 02, 2012 4:06pm C:\projects\Bart\Bart\Drawings\031.dwg

BPerez Jun 05, 2013 - 4:37pm C:\projects\ctas\luperez\ctas\78619\CT00-S-RR-X032.dwg

PAGE NO.	DWG NO.	REV NO.	TITLE
FRONT END GENERAL			
0001	RR-X031	0	TITLE SHEET
0002	RR-X032	2	INDEX OF DRAWINGS
0003	RR-X230	0	GENERAL ABBREVIATIONS SHEET 1 OF 4
0004	RR-X231	0	GENERAL ABBREVIATIONS SHEET 2 OF 4
0005	RR-X232	0	GENERAL ABBREVIATIONS SHEET 3 OF 4
0006	RR-X233	0	GENERAL ABBREVIATIONS SHEET 4 OF 4

RETAINING WALL/SOUND WALL

0007	LS-S100	1	UPRR RETAINING WALL GENERAL PLAN NO. 1 SHEET 1 OF 8
0008	LS-S101	1	UPRR RETAINING WALL GENERAL PLAN NO. 2 SHEET 2 OF 8
0009	LS-S102	1	UPRR RETAINING WALL GENERAL PLAN NO. 3 SHEET 3 OF 8
0010	LS-S103	1	UPRR RETAINING WALL GENERAL PLAN NO. 4 SHEET 4 OF 8
0011	LS-S104	1	UPRR RETAINING WALL GENERAL PLAN NO. 5 SHEET 5 OF 8
0012	LS-S105	1	UPRR RETAINING WALL GENERAL PLAN NO. 6 SHEET 6 OF 8
0013	LS-S106	1	UPRR RETAINING WALL GENERAL PLAN NO. 7 SHEET 7 OF 8
0014	LS-S107	2	UPRR RETAINING WALL GENERAL PLAN NO. 8 SHEET 8 OF 8
0015	LS-S110	2	UPRR RETAINING WALL SOUNDWALL DETAILS
0016	LS-S220	2	UPRR SOUND WALL GENERAL PLAN
0017	LS-S221	2	UPRR SOUND WALL SOUND WALL DETAILS
0018	L5-S285A	0	UPRR RETAINING WALL/SOUND WALLS LOG OF TEST BORINGS 1 OF 6
0019	L5-S286A	0	UPRR RETAINING WALL/SOUND WALLS LOG OF TEST BORINGS 2 OF 6
0020	L5-S287A	0	UPRR RETAINING WALL/SOUND WALLS LOG OF TEST BORINGS 3 OF 6
0021	L5-S288A	0	UPRR RETAINING WALL/SOUND WALLS LOG OF TEST BORINGS 4 OF 6
0022	L5-S289A	0	UPRR RETAINING WALL/SOUND WALLS LOG OF TEST BORINGS 5 OF 6

PAGE NO.	DWG NO.	REV NO.	TITLE
0023	L5-S290A	0	UPRR RETAINING WALL/SOUND WALLS LOG OF TEST BORINGS 6 OF 6
0024	L5-S291A	0	TRACKWAY LOG OF TEST BORINGS, SHEET 1 OF 17
0025	L5-S292A	0	TRACKWAY LOG OF TEST BORINGS, SHEET 2 OF 17
0026	L5-S293A	0	TRACKWAY LOG OF TEST BORINGS, SHEET 3 OF 17
0027	L5-S294A	0	TRACKWAY LOG OF TEST BORINGS, SHEET 4 OF 17
0028	L5-S295A	0	TRACKWAY LOG OF TEST BORINGS, SHEET 5 OF 17
0029	L5-S296A	0	TRACKWAY LOG OF TEST BORINGS, SHEET 6 OF 17
0030	L5-S297A	0	TRACKWAY LOG OF TEST BORINGS, SHEET 7 OF 17
0031	L5-S298A	0	TRACKWAY LOG OF TEST BORINGS, SHEET 8 OF 17

Santa Clara Valley Transportation Authority

☒ NO EXCEPTIONS TAKEN (NET)

☐ MAKE CORRECTIONS NOTED (MCN)

☐ AMEND AND RESUBMIT (A/R)

Any action shown above is subject to the terms of the contract and does not relieve the Contractor of any of its obligations under the contract, including design and detailing.

Contract No.: DB11002F

By:  Date: 7/1/13

2	20130416				RFC REV 1
1	20130114				AMENDMENT 01 TO RFC
0	20121102				READY FOR CONSTRUCTION
REV	DATE	BY	SUB	APP	DESCRIPTION

DESIGNED BY	R. BANKS
DRAWN BY	R. LOPEZ
CHECKED BY	D. CLARY
IN CHARGE	K. ANDERSON
DATE	20130416




Skanska Shimmick Herzog

1436 California Circle
Milpitas, California 95035
A Joint Venture

Lockwood, Andrews & Newnam, Inc.
A DALY COMPANY

T-Y LIN INTERNATIONAL

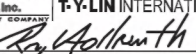
APPROVED 



LINE, TRACK, STATIONS, AND SYSTEMS
DESIGN UNIT 018 - WORK PACKAGE 04
RETAINING WALL/SOUND WALL
INDEX OF DRAWINGS

CADD FILENAME	C700-S-RR-X032.dwg
SIZE	SCALE
D	NOT TO SCALE
CONTRACT NO.	C700
AREA CODE	RR
SHEET NO.	X032
PAGE NO.	0002

Nov 02, 2012 3:53pm C:\projects\berryessa\berryessa\Drawings\0200-5-RR-X232.dwg B:\Perez

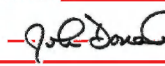- N -					- P -					- Q -					- R -					- S -					- O -						
N	NORTH, NEUTRAL				OSP	OUTSIDE PLANT				PRKG	PARKING				RJ	AUDIO FREQ. TRACK INTERMEDIATE				SLR	SEALER				Santa Clara Valley Transportation Authority ✓ NO EXCEPTIONS TAKEN (NET) MAKE CORRECTIONS NOTED (MCN) AMEND AND RESUBMIT (A/R) Any action shown above is subject to the terms of the contract and does not relieve the Contractor of any of its obligations under the contract, including design and detailing. Contract No.: DB11002F By:  Date: 7/1/13	SHORT LEG VERTICAL					
(N)	NEW				OSYT	NEW HALL YARD CONTROL TOWER				PROT	PROPERTY, PROPOSED				RL	TRACK RELAY				SLV	SOUTHERLY					SINGLE MODE (FIBER CABLE),					
N/A	NOT APPLICABLE				OTDR	OPTICAL TIME DOMAIN REFLECTOMETER				PRS	PROTECTOR				RLA	REFRIGERANT LIQUID				S'LY	SOLID MANGANESE FROG,										
N/R	NON-RELATED				OTE	OVER TRACK EXHAUST				PRV	PAIRS				RLY	RATED LOAD AMPS				SM	SWITCH MACHINE										
N12	NEGATIVE 12V DC				OTM	OTHER TRACK MATERIAL				PRVAL	PRESSURE REDUCING VALVE				RM	RELAY				SMF	SINGLE MODE FIBER										
N28	NEGATIVE 28V DC				OTN	OPTICAL TRANSPORT NETWORK				PRVC	PRESSURE RELIEF VALVE				RN	REFERENCE NORTH				SMH	SANITARY MANHOLE										
NAD27	NORTH AMERICAN DATUM OF 1927 (HORIZONTAL)				OV	OUTLET VELOCITY, OUTSIDE VELOCITY				PS	POINT ON REVERSE VERTICAL CURVE				RNS	RUNNING RAIL NEGATIVE RETURN SWITCH				SND	SANITARY NAPKIN DISPENSER										
NAD83	NORTH AMERICAN DATUM OF 1983 (HORIZONTAL)				OVC	OVERCROSSING				PS/L	POINT OF SWITCH, POSITION SWITCH, POWER SUPPLY, PUMP STATION, PRE-STRESSED				RO	ROUGH OPENING				SNF	SWING NOSE FROG, MOVABLE POINT FROG										
NAVD88	NORTH AMERICAN VERTICAL DATUM OF 1988				P	POWER LINE, PAINT, NON-VITAL REPEATER				PSE	PROTECTOR SHELF/L BLOCK				RPM	REFERENCE POINT				SNR	SANITARY NAPKIN RECEPACLE										
NB	NEGATIVE BUS, NORTH BOUND					POWER AND SUPPORT				PUBLIC SERVICE EASEMENT				POUNDS PER SQUARE INCH				REVOLUTIONS PER MINUTE				STATION NETWORK TERMINAL									
NC	NOISE CRITERIA, NORMALLY CLOSED				P&S	POWER AND WAY				PSI	POUNDS PER SQUARE INCH				RPT	PAPER TOWEL DISPENSER & RECEPTACLE				SOE	REPEATER					SUPPORT OF EXCAVATION					
NE	NORTHEAST				P&W	PULLBOX OR PUSH BUTTON				PSIG	PUBLIC SWITCHED TELEPHONE NETWORK				RS	REFRIGERANT SUCTION, RIPARIAN				SOL	SETBACK					SOLENOID					
NEC	NATIONAL ELECTRIC CODE				P.B., PB	PROPERTY LINE				PSTN	POINT, POINT OF TANGENT, POINT OF CHANGE FROM CIRCULAR CURVE TO TANGENT, POTENTIAL TRANSFORMER, PORCELAIN TILE, PETROLEUM				RSC	RIGID STEEL CONDUIT				SOM	RIGID STEEL CONDUIT					SOMASTIC COATED PIPE					
NEG	NEGATIVE				P/L	PROPERTY LINE				PT	PAPER TOWEL DISPENSER & RECEPTACLE				RSP	ROCK SLOPE PROTECTION				SONET	SYNCHRONOUS OPTICAL NETWORK					SEQUENTIAL OCCUPANCY RELEASE SYSTEM					
NEG RET	NEGATIVE RETURN				P/O	PART OF				PTD/R	PUSH TO TALK				RST	RESTRICTED SPEED RELAY				SOV	SHUT-OFF VALVE					STEEL PIPE, SUMP PUMP, STATIC PRESSURE, SPARE, SPLICE					
NE'LY	NORTHEASTERLY				PA	PUBLIC ADDRESS				PTEAC	PLATFORM TRIP MODULE				RT	RIGHT, ROUTE, RANDOM TWIST				SP	ROUTE					BART SPUR TRACK					
NGS	NATIONAL GEODETIC SURVEY				PABX, PBX	PRIVATE AUTOMATIC BRANCH EXCHANGE				PTM	PERMIT TO ENTER AND CONSTRUCT				RTAC	ROOF TOP AIR CONDITIONING UNIT				SPA	REMOTE TERMINAL UNIT					SPACES, SPACING					
NIC	NOT IN CONTRACT				PAE	PEDESTRIAN ACCESS EASEMENT				PTS	PLATFORM TRIP STATION				RTD	RESISTANCE TEMPERATURE DETECTOR				SPD	ROOF VENTILATOR					SANITARY PRESSURE DISCHARGE					
NIT	NITROGEN GAS LINE				PART	PARTNERS				PTT	PUSH TO TALK				RTE	ROUTE				SPT	RECLAIMED WATER, RETAINING WALL					SINGLE POLE DOUBLE THROW					
NK	NECK				PATS	PROPERTY ACQUISITION TRACKING SYSTEM				PTZ	PAN, TILT AND ZOOM				RTU	ROUTE				SPDT	REVERSE SWITCH REPEATER RELAY					SPECIFICATION					
N'LY	NORTHERLY				PB	PULL BOX, PUSH BUTTON				PU	POWER UNIT				RV	REVERSE SWITCH REPEATER RELAY				SPK	RECEIVED					SPEAKER					
nm	NANOMETER				PC	PERSONAL COMPUTER, PRECAST, PRECAST CONCRETE, POINT OF CURVATURE, POINT OF CHANGE FROM TANGENT TO CIRCULAR CURVE				PUE	PUSH TO TALK				RW	RECEIVED				SPO	RECEIVED					POINT OF ORIGIN OF COMPOUND SPIRAL					
NMC	NON-METALLIC CONDUIT				PCC	PORTLAND CEMENT CONCRETE, POINT OF CURVATURE, POUND PER CUBIC FOOT				PVC	PUSH TO TALK				RWC	RECEIVED				SPRK	RECEIVED					SPRINKLER					
NMS	NETWORK MANAGEMENT SYSTEM					PCF	PORTLAND CEMENT CONCRETE, POINT OF CURVATURE, POUND PER CUBIC FOOT				PVT	PUSH TO TALK				RWL	RECEIVED				SPRR COMM	RECEIVED					SOUTHERN PACIFIC RAILROAD COMMUNICATION				
NO	NORMALLY OPEN, NUMBER				PCM	PORTLAND CEMENT CONCRETE, POINT OF CURVATURE, POUND PER CUBIC FOOT				PVMT	PUSH TO TALK				RWLOL	RECEIVED				SPSC	RECEIVED					SWITCH POWER SUPPLY CABINET, SWITCH MACHINE POWER SUPPLY CABINET					
NO(S)	NUMBERS				PCR	PORTLAND CEMENT CONCRETE, POINT OF CURVATURE, POUND PER CUBIC FOOT				PWR	PUSH TO TALK				RX, RCV (R)	RECEIVED				SPST	RECEIVED					SINGLE POLE SINGLE THROW					
NOM	NOMINAL				PCTL	PORTLAND CEMENT CONCRETE, POINT OF CURVATURE, POUND PER CUBIC FOOT				QR	PORTLAND CEMENT CONCRETE, POINT OF CURVATURE, POUND PER CUBIC FOOT				S	POWER UNIT				SPT	RECEIVED					SPRINT COMMUNICATIONS					
NON-ESS	NON-ESSENTIAL					PCVC	PORTLAND CEMENT CONCRETE, POINT OF CURVATURE, POUND PER CUBIC FOOT				QS	PORTLAND CEMENT CONCRETE, POINT OF CURVATURE, POUND PER CUBIC FOOT				SO.	POWER UNIT				SPTC	RECEIVED					SOLDIER PILE TREMIE CONCRETE				
NOR	NORMAL				PD	PORTLAND CEMENT CONCRETE, POINT OF CURVATURE, POUND PER CUBIC FOOT				QTY	PORTLAND CEMENT CONCRETE, POINT OF CURVATURE, POUND PER CUBIC FOOT				S.I.C.	POWER UNIT				SPWG	RECEIVED					STATIC PRESSURE WATER GAUGE					
NOTC	NORMALLY OPEN TIME CLOSED				PDU	PORTLAND CEMENT CONCRETE, POINT OF CURVATURE, POUND PER CUBIC FOOT				R	PORTLAND CEMENT CONCRETE, POINT OF CURVATURE, POUND PER CUBIC FOOT				S1	POWER UNIT				SQ	RECEIVED					SQUARE					
NS	NEAR SIDE				PE	PORTLAND CEMENT CONCRETE, POINT OF CURVATURE, POUND PER CUBIC FOOT				R/C	PORTLAND CEMENT CONCRETE, POINT OF CURVATURE, POUND PER CUBIC FOOT				S2	POWER UNIT				SQ.FT.	RECEIVED					SQUARE FOOT (FEET)					
NTS	NOT TO SCALE				PERF	PORTLAND CEMENT CONCRETE, POINT OF CURVATURE, POUND PER CUBIC FOOT				R NO.	PORTLAND CEMENT CONCRETE, POINT OF CURVATURE, POUND PER CUBIC FOOT				S3	POWER UNIT				SQYD,SY	RECEIVED					SQUARE YARD					
NV	NON-VITAL				PERM	PORTLAND CEMENT CONCRETE, POINT OF CURVATURE, POUND PER CUBIC FOOT				R/C	PORTLAND CEMENT CONCRETE, POINT OF CURVATURE, POUND PER CUBIC FOOT				Sa	POWER UNIT				SR	RECEIVED					SUPPLY REGISTER					
NVI	NON-VITAL INPUT				PERM MTL	PORTLAND CEMENT CONCRETE, POINT OF CURVATURE, POUND PER CUBIC FOOT				R/R	PORTLAND CEMENT CONCRETE, POINT OF CURVATURE, POUND PER CUBIC FOOT				SAB	POWER UNIT				SS	RECEIVED					RIGHT CIRCUIT (34.5KV TPSS)					
NVO	NON-VITAL OUTPUT				PET, PETRO,	PORTLAND CEMENT CONCRETE, POINT OF CURVATURE, POUND PER CUBIC FOOT				R/R	PORTLAND CEMENT CONCRETE, POINT OF CURVATURE, POUND PER CUBIC FOOT				SAN	POWER UNIT				SSCO	RECEIVED					SELECTOR SWITCH, STAINLESS STEEL, SANITARY SEWER, SUBSTATION, POINT OF CHANGE FROM ONE SPIRAL TO ANOTHER					
NVR	NETWORK VIDEO RECORDER				PT	PORTLAND CEMENT CONCRETE, POINT OF CURVATURE, POUND PER CUBIC FOOT				R/R	PORTLAND CEMENT CONCRETE, POINT OF CURVATURE, POUND PER CUBIC FOOT				SAR	POWER UNIT				SSE	RECEIVED					SANITARY SEWER CLEANOUT					
NW	NORTHWEST				PF	PORTLAND CEMENT CONCRETE, POINT OF CURVATURE, POUND PER CUBIC FOOT				R/R	PORTLAND CEMENT CONCRETE, POINT OF CURVATURE, POUND PER CUBIC FOOT				SAT	POWER UNIT				SSK	RECEIVED					SUBSURFACE EASEMENT, SANITARY SEWER EASEMENT					
NWCR	SWITCH NORMAL CORRESPONDENCE RELAY				PG	PORTLAND CEMENT CONCRETE, POINT OF CURVATURE, POUND PER CUBIC FOOT				R/R	PORTLAND CEMENT CONCRETE, POINT OF CURVATURE, POUND PER CUBIC FOOT				SB	POWER UNIT				SSM	RECEIVED					SERVICE SINK					
NW'LY	NORTHWESTERLY				PGA	PORTLAND CEMENT CONCRETE, POINT OF CURVATURE, POUND PER CUBIC FOOT				R/R	PORTLAND CEMENT CONCRETE, POINT OF CURVATURE, POUND PER CUBIC FOOT				SBGR	POWER UNIT				SSMH, SMH	RECEIVED					SANITARY SEWER MANHOLE					
NWPR	NORMAL SWITCH REPEATER RELAY				PGL	PORTLAND CEMENT CONCRETE, POINT OF CURVATURE, POUND PER CUBIC FOOT				R/R	PORTLAND CEMENT CONCRETE, POINT OF CURVATURE, POUND PER CUBIC FOOT				SBO	POWER UNIT				SSR	RECEIVED					SOUTH STICK RELAY					
NX	AC VOLTAGE				POT	PORTLAND CEMENT CONCRETE, POINT OF CURVATURE, POUND PER CUBIC FOOT				R/R	PORTLAND CEMENT CONCRETE, POINT OF CURVATURE, POUND PER CUBIC FOOT				SC	POWER UNIT				SSS	RECEIVED					SYSTEM SELECTOR SWITCH					
NX12	12VAC				PH	PORTLAND CEMENT CONCRETE, POINT OF CURVATURE, POUND PER CUBIC FOOT				R/R	PORTLAND CEMENT CONCRETE, POINT OF CURVATURE, POUND PER CUBIC FOOT				SCAC	POWER UNIT				SST	RECEIVED					SOAP STONE					
NXTGEN	ARCHITECTURE OF BART'S NEXT GENERATION EQUIPMENT				PI	PORTLAND CEMENT CONCRETE, POINT OF CURVATURE, POUND PER CUBIC FOOT				R/R	PORTLAND CEMENT CONCRETE, POINT OF CURVATURE, POUND PER CUBIC FOOT				SCADA	POWER UNIT				ST	RECEIVED					STREET, SAINT, POINT OF CHANGE FROM SPIRAL TO TANGENT, STONE TILE					
O	OPTICAL				PIDS	PORTLAND CEMENT CONCRETE, POINT OF CURVATURE, POUND PER CUBIC FOOT				R/R	PORTLAND CEMENT CONCRETE, POINT OF CURVATURE, POUND PER CUBIC FOOT				SCD	POWER UNIT				STA	RECEIVED					ALIGNMENT STATION, STATION, STATIONING					
O/	OVER				PIN	PORTLAND CEMENT CONCRETE, POINT OF CURVATURE, POUND PER CUBIC FOOT				R/R	PORTLAND CEMENT CONCRETE, POINT OF CURVATURE, POUND PER CUBIC FOOT				SCS	POWER UNIT				STBY	RECEIVED					STANDBY					
O/L	OVERLOAD				PITO	PORTLAND CEMENT CONCRETE, POINT OF CURVATURE, POUND PER CUBIC FOOT				R/R	PORTLAND CEMENT CONCRETE, POINT OF CURVATURE, POUND PER CUBIC FOOT				SCH	POWER UNIT				STC	RECEIVED					SOUND TRANSMISSION CLASS					
O/C	OVERCURRENT				PIV	PORTLAND CEMENT CONCRETE, POINT OF CURVATURE, POUND PER CUBIC FOOT				R/R	PORTLAND CEMENT CONCRETE, POINT OF CURVATURE, POUND PER CUBIC FOOT				SCHP	POWER UNIT				STD	RECEIVED					STANDARD					
OA	OVERALL, OUTSIDE AIR				PVC	PORTLAND CEMENT CONCRETE, POINT OF CURVATURE, POUND PER CUBIC FOOT				R/R	PORTLAND CEMENT CONCRETE, POINT OF CURVATURE, POUND PER CUBIC FOOT				SCN	POWER UNIT				STE	RECEIVED					SPECIAL TEST EQUIPMENT					
OAD	OUTSIDE AIR DAMPER				PL	PORTLAND CEMENT CONCRETE, POINT OF CURVATURE, POUND PER CUBIC FOOT				R/R	PORTLAND CEMENT CONCRETE, POINT OF CURVATURE, POUND PER CUBIC FOOT				SCTB	POWER UNIT				STIFF	RECEIVED					STIFFENER					
OADM	OPTICAL ADD/DROP MULTIPLEXER				PLAS	PORTLAND CEMENT CONCRETE, POINT OF CURVATURE, POUND PER CUBIC FOOT				R/R	PORTLAND CEMENT CONCRETE, POINT OF CURVATURE, POUND PER CUBIC FOOT				SD	POWER UNIT				STL	RECEIVED					STEEL					
OAMP	OPERATIONS ALARMS MAINTENANCE PROVISIONING				PLC	PORTLAND CEMENT CONCRETE, POINT OF CURVATURE, POUND PER CUBIC FOOT				R/R	PORTLAND CEMENT CONCRETE, POINT OF CURVATURE, POUND PER CUBIC FOOT				SDCB	POWER UNIT				STOPR	RECEIVED					STOP SPEED COMMAND RELAY					
OC	ON CENTER, OVERCROSSING, OPTICAL CARRIER				PLP	PORTLAND CEMENT CONCRETE, POINT OF CURVATURE, POUND PER CUBIC FOOT				R/R	PORTLAND CEMENT CONCRETE, POINT OF CURVATURE, POUND PER CUBIC FOOT				SDE	POWER UNIT				STOR	RECEIVED					STORAGE					
OC1	51.84 Mb/s OPTICAL CARRIER LEVEL 1				PLUM	PORTLAND CEMENT CONCRETE, POINT OF CURVATURE, POUND PER CUBIC FOOT				R/R	PORTLAND CEMENT CONCRETE, POINT OF CURVATURE, POUND PER CUBIC FOOT				SDM	POWER UNIT				STR	RECEIVED					STAIR, STRANDED					
OC192	9.92 Gb/s OPTICAL CARRIER LEVEL 192				PNEU	PORTLAND CEMENT CONCRETE, POINT OF CURVATURE, POUND PER CUBIC FOOT				R/R	PORTLAND CEMENT CONCRETE, POINT OF CURVATURE, POUND PER CUBIC FOOT				SDP	POWER UNIT				STRUC	RECEIVED					STRUCTURAL, STRUCTURE					
OC1-OC192	OPTICAL CARRIER LEVEL 1 THRU OPTICAL CARRIER LEVEL 192				POE	PORTLAND CEMENT CONCRETE, POINT OF CURVATURE, POUND PER CUBIC FOOT				R/R	PORTLAND CEMENT CONCRETE, POINT OF CURVATURE, POUND PER CUBIC FOOT				SE	POWER UNIT				STS	RECEIVED					SYNCHRONOUS TRANSPORT SIGNAL					
OC3	Mb/s OPTICAL CARRIER LEVEL 3				POS	PORTLAND CEMENT CONCRETE, POINT OF CURVATURE, POUND PER CUBIC FOOT				R/R	PORTLAND CEMENT CONCRETE, POINT OF CURVATURE, POUND PER CUBIC FOOT				SEC	POWER UNIT				SUB	RECEIVED					SUBSTATION					
OC48	Gb/s OPTICAL CARRIER LEVEL 48				POT	PORTLAND CEMENT CONCRETE, POINT OF CURVATURE, POUND PER CUBIC FOOT				R/R	PORTLAND CEMENT CONCRETE, POINT OF CURVATURE, POUND PER CUBIC FOOT				SECT	POWER UNIT				SUPP	RECEIVED					SUPPLY					
OCC	OPERATIONAL CONTROL CENTER				POVC	PORTLAND CEMENT CONCRETE, POINT OF CURVATURE, POUND PER CUBIC FOOT				R/R	PORTLAND CEMENT CONCRETE, POINT OF CURVATURE, POUND PER CUBIC FOOT				SECT	POWER UNIT				SUSP	RECEIVED					SUSPENDED					
OD	OUTSIDE DIAMETER				POVT	PORTLAND CEMENT CONCRETE, POINT OF CURVATURE, POUND PER CUBIC FOOT				R/R	PORTLAND CEMENT CONCRETE, POINT OF CURVATURE, POUND PER CUBIC FOOT				SE'LY	POWER UNIT				SV	RECEIVED					TUNNEL VENTILATION FAN, SOLID VEE					
OFCI	OWNER FURNISHED CONTRACTOR INSTALLED				PP	PORTLAND CEMENT CONCRETE, POINT OF CURVATURE, POUND PER CUBIC FOOT				R/R	PORTLAND CEMENT CONCRETE, POINT OF CURVATURE, POUND PER CUBIC FOOT				SES	POWER UNIT				SVC	RECEIVED					FROG, SHEET VINYL					
OFD	OVERFLOW DRAIN				PP	PORTLAND CEMENT CONCRETE, POINT OF CURVATURE, POUND PER CUBIC FOOT				R/R	PORTLAND CEMENT CONCRETE, POINT OF CURVATURE, POUND PER CUBIC FOOT				SF	POWER UNIT				SVR	RECEIVED					SERVICE					
OFR	ON-FREQUENCY REPEATER				PPP	PORTLAND CEMENT CONCRETE, POINT OF CURVATURE, POUND PER CUBIC FOOT				R/R	PORTLAND CEMENT CONCRETE, POINT OF CURVATURE, POUND PER CUBIC FOOT				SG	POWER UNIT				SW	RECEIVED					SERVER					
OG	ORIGINAL GROUND				PPTIM	PORTLAND CEMENT CONCRETE, POINT OF CURVATURE, POUND PER CUBIC FOOT				R/R	PORTLAND CEMENT CONCRETE, POINT OF CURVATURE, POUND PER CUBIC FOOT				SH	POWER UNIT				SWAC POR	RECEIVED					SWITCH MACHINE POWER OFF					
OH	OVERHEAD, OVERHEAD LINE				PR	PORTLAND CEMENT CONCRETE, POINT OF CURVATURE, POUND PER CUBIC FOOT				R/R	PORTLAND CEMENT CONCRETE, POINT OF CURVATURE, POUND PER CUBIC FOOT				SHG	POWER UNIT				SWBD	RECEIVED					SWITCH BOARD					
OHE	OVERHEAD ELECTRICAL LINE				PRI	PORTLAND CEMENT CONCRETE, POINT OF CURVATURE, POUND PER CUBIC FOOT				R/R	PORTLAND CEMENT CONCRETE, POINT OF CURVATURE, POUND PER CUBIC FOOT				SHH	POWER UNIT				SWGR	RECEIVED					SWITCH GEAR					
OHE/T	OVERHEAD ELECTRICAL AND TELEPHONE				PRC	PORTLAND CEMENT CONCRETE, POINT OF CURVATURE, POUND PER CUBIC FOOT				R/R	PORTLAND CEMENT CONCRETE, POINT OF CURVATURE, POUND PER CUBIC FOOT				SHC	POWER UNIT				SWL	RECEIVED					SOUNDWALL					
OHT	OVERHEAD TELEPHONE LINE				PRC	PORTLAND CEMENT CONCRETE, POINT OF CURVATURE, POUND PER CUBIC FOOT				R/R	PORTLAND CEMENT CONCRETE, POINT OF CURVATURE, POUND PER CUBIC FOOT				SHL	POWER UNIT				SW'LY	RECEIVED					SOUTHWESTERLY					
OHTV	OVERHEAD TV LINE				PRI	PORTLAND CEMENT CONCRETE, POINT OF CURVATURE, POUND PER CUBIC FOOT				R/R	PORTLAND CEMENT CONCRETE, POINT OF CURVATURE, POUND PER CUBIC FOOT				SHR	POWER UNIT				SWR	RECEIVED					SYSTEMWIDE RACEWAY					
OL	OVERLOAD CONTACT				PRC	PORTLAND CEMENT CONCRETE, POINT OF CURVATURE, POUND PER CUBIC FOOT				R/R	PORTLAND CEMENT CONCRETE, POINT OF CURVATURE, POUND PER CUBIC FOOT				SHT	POWER UNIT				SWS	RECEIVED					SWITCHING STATION					
OPNG	OPENING				PRC	PORTLAND CEMENT CONCRETE, POINT OF CURVATURE, POUND PER CUBIC FOOT				R/R	PORTLAND CEMENT CONCRETE, POINT OF CURVATURE, POUND PER CUBIC FOOT				SIG	POWER UNIT				SWT PT	RECEIVED					SWITCH POINT					
OPP	OPPOSITE				PRC	PORTLAND CEMENT CONCRETE, POINT OF CURVATURE, POUND PER CUBIC FOOT				R/R	PORTLAND CEMENT CONCRETE, POINT OF CURVATURE, POUND PER CUBIC FOOT				SIM	POWER UNIT				SY	RECEIVED					SQUARE YARD					
OPP HND	OPPOSITE HAND				PRC	PORTLAND CEMENT CONCRETE, POINT OF CURVATURE, POUND PER CUBIC FOOT				R/R	PORTLAND CEMENT CONCRETE, POINT OF CURVATURE, POUND PER CUBIC FOOT				SJW TEST	POWER UNIT				SYM	RECEIVED					SYMMETRICAL					
OPT	OPTION, OPTIMAL				PRC	PORTLAND CEMENT CONCRETE, POINT OF CURVATURE, POUND PER CUBIC FOOT				R/R	PORTLAND CEMENT CONCRETE, POINT OF CURVATURE, POUND PER CUBIC FOOT				SL	POWER UNIT				SYS	RECEIVED					SYSTEM(S)					
OPX	OFF-PREMISE EXTENSION				PRC	PORTLAND CEMENT CONCRETE, POINT OF CURVATURE, POUND PER CUBIC FOOT				R/R	PORTLAND CEMENT CONCRETE, POINT OF CURVATURE, POUND PER CUBIC FOOT				SLPA	POWER UNIT															
OS	OPERATING SYSTEM				PRC	PORTLAND CEMENT CONCRETE, POINT OF CURVATURE, POUND PER CUBIC FOOT				R/R	PORTLAND CEMENT CONCRETE, POINT OF CURVATURE, POUND PER CUBIC FOOT																				
OSA	OUTSIDE AIR				PRC	PORTLAND CEMENT CONCRETE, POINT OF CURVATURE, POUND PER CUBIC FOOT				R/R	PORTLAND CEMENT CONCRETE, POINT OF CURVATURE, POUND PER CUBIC FOOT																				
OSI	OPEN SYSTEMS INTERCONNECTION				PRC	PORTLAND CEMENT CONCRETE, POINT OF CURVATURE, POUND PER CUBIC FOOT				R/R	PORTLAND CEMENT CONCRETE, POINT OF CURVATURE, POUND PER CUBIC FOOT																				

DESIGNED BY R. BANKS						Skanska Shimmick Herzog					1436 California Circle Milpitas, California 95035 A Joint Venture					LOCKWOOD, ANDREWS & NEWMAN, INC. A LEO A DALY COMPANY					T-Y-LIN INTERNATIONAL									
DRAWN BY M. HALL																														
CHECKED BY D. CLARY																														
IN CHARGE K. ANDERSON																														
DATE 20121102																														
O	20121102					READY FOR CONSTRUCTION																								
REV	DATE	BY	SUB	APP	DESCRIPTION																									

LINE, TRACK, STATIONS, AND SYSTEMS					GENERAL ABBREVIATIONS SHEET 3 OF 4					CADD FILENAME C700-S-RR-X232.dwg									
SIZE D					NOT TO SCALE					CONTRACT NO. C700					REV. 0				
AREA CODE RR					X232					SHEET NO. 0005					PAGE NO.				

B:\Perez Nov 02, 2012 4:34:47pm C:\proj\cthes\luzerrez\dmw78618\c700-S-RR-X233.dwg


- T -		- X -		ADDITIONAL HORIZONTAL AND VERTICAL ALIGNMENT NOMENCLATURE			
t	THICKNESS	TIM	TENANT IMPROVEMENT, TRAIN INFORMATION MONITOR	X ,		k ₁	TANGENT DISTANCE OF SHIFTED PC REFERRED TO THE TS
T	TELEPHONE, COMMUNICATION LINE, TOP, TRANSFORMER, TREAD, TIP, TRANSDUCER, THERMOSTAT	TL	TREE LIGHTING	X-OVER	CROSSOVER (TRACK)	k ₂	TANGENT DISTANCE OF SHIFTED PT REFERRED TO THE ST
T&B	TOP & BOTTOM	TM	TERMINAL ZONE	X/O	CROSSOVER	Lc	TOTAL LENGTH OF CIRCULAR CURVE FROM PC TO PT OR SC TO CS
T&P	TEMPERATURE AND PRESSURE RELIEF VALVE	TMH	TELEPHONE MANHOLE	XCVR	TRANSCIVER	Lsc	LENGTH OF COMPOUND SPIRAL FROM CS TO SC
T.O., T/O	TURNOUT	TN	TRUE NORTH	XFMR	TRANSFORMER	LS ₁	LENGTH OF SPIRAL FROM TS TO SC
T/	TOP OF	T.O.	TORQUE OIL REEL	XING	CROSSING	LS ₂	LENGTH OF SPIRAL FROM CS TO ST
T/C, T.C.	TRAIN CONTROL	TOC	TOP OF CONCRETE	XL	INTERLOCKING ZONE	pc	OFFSET BETWEEN CIRCLES AT POINT OF COMPOUND CURVATURE
T/P	TOP OF PAVEMENT, TOP OF PIPE	TOD	TRANSIT ORIENTED DEVELOPMENT	XMT, XMIT	TRANSMIT	P ₁	OFFSET FROM INITIAL TANGENT TO PC OF THE SHIFTED CIRCLE OF SPIRALIZED CURVE
T/R	TOP OF RAIL	TOF	TOP OF FOOTING	XMTB	TRANSMITTER	P ₂	OFFSET FROM INITIAL TANGENT TO PT OF THE SHIFTED CIRCLE OF SPIRALIZED CURVE
T/W	TOP OF WALL	TOL	TOLERANCE	XSR	DIRECTIONAL ROUTE LOCKING RELAY	Rc	RADIUS OF CIRCULAR CURVE
T1	T1 TELEPHONE CARRIER	TOS	TOP OF STRUCTURE (STEEL, SLAB)	XT	X-TERMINAL COMPUTER	TS ₁	TANGENT DISTANCE FROM TS TO PI
TA	TRUNK AMPLIFIER	TOT	TOTAL			TS ₂	TANGENT DISTANCE FROM ST TO PI
TAH	TEMPERATURE ALARM HIGH	TOW	TOP OF WALL			TS	POINT OF CHANGE FROM TANGENT TO SPIRAL
TAN	TANGENT	TP	TRACTION POWER, TWISTED PAIR, TRAP PRIMER, TEST PIT, TRANSMISSION PRESSURE			Xs ₁	TANGENT DISTANCE AT THE SC
TB	TERMINAL BOX, TERMINAL BLOCKS, TEST BORING	TPD	TOILET PAPER DISPENSER			Xs ₂	TANGENT DISTANCE AT THE CS
TBD	TO BE DETERMINED	TPSS	TRACTION POWER SUB STATION			Ys ₁	TANGENT OFFSET AT THE SC
TBDC	TO BE DETERMINED BY THE CONTRACTOR	TR	TRACK RELAY, TREAD			Ys ₂	TANGENT OFFSET AT THE CS
	TROUBLE	TRACS	TRUNKED RADIO AND COMMUNICATIONS SYSTEMS			Δ	TOTAL CENTRAL ANGLE OF THE SPIRALIZED CURVE
TBL	TUNNEL BORING MACHINE	TRANS	TRANSFORMER, TRANSITION, TRANSVERSE			Δ _c	CENTRAL ANGLE OF CIRCULAR CURVE (Lc) FROM SC TO CS
TBM	TERMINATION BLOCK POST	TR-FO	TRUNKED RADIO FIBER OPTIC INTERFACE			Δ _{c1}	CENTRAL ANGLE OF FIRST CIRCULAR CURVE OF COMPOUND CURVATURE
TBP	TIME CLOCK, TOP OF CURB, TRAIN CONTROL, TERMINAL CABINET, TEMPERATURE CONTROLLER	TRK	TRACK			Δ _{c2}	CENTRAL ANGLE OF SECOND CIRCULAR CURVE OF COMPOUND CURVATURE
TC	TIME CLOCK, TOP OF CURB, TRAIN CONTROL, TERMINAL CABINET, TEMPERATURE CONTROLLER	TS	POINT OF CHANGE FROM TANGENT TO SPIRAL, TRAFFIC SIGNAL, TUBE SECTION, TUBE STEEL, TEST SWITCH			∠s ₁	CENTRAL ANGLE OF SPIRAL LENGTH Ls ₁ OR SPIRAL ANGLE OF FIRST SPIRAL IN SPIRALIZED CURVE
TC/C	TRAIN CONTROL & COMMUNICATIONS	TSL	TRAFFIC SIGNAL			∠s ₂	CENTRAL ANGLE OF SPIRAL LENGTH Ls ₂ OR SPIRAL ANGLE OF SECOND SPIRAL IN SPIRALIZED CURVE
TCB	TRAIN CONTROL BUILDING	TSP	TOTAL STATIC PRESSURE			∠s ₃	CENTRAL ANGLE OF COMPOUND SPIRAL OR COMPOUND SPIRAL ANGLE FROM CS TO SC
TCC	TOTAL COOLING CAPACITY	TT	TRANSFER TRIP			#10	TRACK TURNOUT DESIGNATION
TCE	TEMPORARY CONSTRUCTION EASEMENT	TTC	TRANSFER TRIP CABINET			#15 EQ	EQUALATERAL TURNOUT
TCH	TRAIN CONTROL HOUSE	TV	TELEVISION, TURNING VANE				
TCP	TEMPERATURE CONTROL PANEL, TRANSPORT CONTROL PROTOCOL	TVE	TUNNEL VENTILATION EQUIPMENT				
TCR	TRAIN CONTROL ROOM	TVF	TUNNEL VENTILATION FAN				
TCS	TELEMETRY CABLE SPLICE	TVM(S)	TICKET VENDING MACHINE(S)				
TCSA	TEMPORARY CONSTRUCTION STAGING AREA	TVS	TUNNEL VENTILATION SHAFT				
	TRACK CIRCUIT TUNING	TW	TRAVELED WAY				
TCT	TRENCH DRAIN, TUNNEL DAMPER, TIRE DERIVED AGGREGATE	TWA	TRANSPARENT WALL ASSEMBLY				
TD	TIME DELAY CLOSE	TWC	TRAIN-TO-WAYSIDE COMMUNICATIONS				
TDA	TIME DELAY CLOSE RELAY	TWPR	TWISTED PAIR				
TDC	TUNNEL DAMPER CLOSE RELAY	TWR	TOWER				
TDCR	TELECOMMUNICATIONS DEVICE FOR THE DEAF	TX, XMT	TRANSMIT				
TDD	TIME DELAY DROPOUT	TYP	TYPICAL				
TDDO	TIME DELAY DE-ENERGIZING RELAY						
TDF	TIME DELAY OPEN						
TDO	TUNNEL DAMPER OPEN RELAY						
TDOR	TIME DELAY PICK UP						
TDPU	TIME DELAY DE-ENERGIZING RELAY						
TDR	TEMPERATURE ELEMENT, THREADED END						
TE	MOTOR BEARING TEMPERATURE (RTD'S)						
TEB	TEMPERATURE ELEMENT MOTOR ENCLOSURE SPACE HEATER						
TEH	BURIED TEL, TELEPHONE						
TEL	TELEPHONE COMPANY						
TELCO	TELECOMMUNICATIONS						
TELECOM	TELEPHONE VAULT						
TELVLT	TEMPERATURE, TEMPORARY						
TEMP	TIMER RELAY, TERRATZO						
TER	MOTOR WINDING TEMPERATURE (RTD'S)						
TEW	TRACK FEET, TRANSFER (ATO TO MANUAL OR MANUAL TO ATO), FORWARD CURRENT CONDUCTION						
TF	TUNNEL VENTILATION FAN DAMPER						
TFD	TETRAFLUOROETHYLENE						
TFE	TOP OF GRATE (ELEVATION), TRANSFER GRILLE						
TG	TEST HOLE (SUBSURFACE INVESTIGATION)						
TH	TELEPHONE HAND HOLE						
THH	THICK, THICKNESS						
THK	TOTAL HEAT REJECTION						
THR	THROUGH						
THRU	TEMPERATURE INDICATION						
TI	TEMPERATURE INDICATION CONTROL (HIGH/LOW)						
TICHL	TEMPORARY INGRESS/EGRESS EASEMENT						
TIEE	TEMPERATURE INDICATION HIGH FOR MOTOR ENCLOSURE OR BEARINGS						
TIH							




VAR	VOLT-AMPERE REACTIVE, VARIES		
VAV	VARIABLE AIR VOLUME, VARIABLE AIR DAMPER		
VB	VACUUM BREAKER		
VC	VERTICAL CURVE, VITRIFIED CLAY, VIDEO CARD		
VCD	VITRIFIED CLAY DUCT		
VCN	VERTICAL CIRCULATION NODE		
VCP	VENTILATION CONTROL PANEL, VITRIFIED CLAY PIPE		
VCT	VINYL COMPOSITION TILE		
VCTB	VINYL COVERED TACK BOARD		
VD	VOLUME DAMPER, VIBRATION DETECTOR		
VDA	VIDEO DISTRIBUTION AMPLIFIER		
VDC	VOLTS DIRECT CURRENT		
VE	MOTOR VIBRATION DETECTOR, VIBRATION ELEMENT		
VEL	VELOCITY		
VENT	VENTILATION		
VERT	VERTICAL		
VEST	VESTIBULE		
VF	VOICE FREQUENCY		
VFD	VARIABLE FREQUENCY DRIVE		
VHF	VERY HIGH FREQUENCY		
VI	VIBRATION INDICATOR		
VIB	MOTOR VIBRATION		
VIH	VIBRATION INDICATION HIGH		
VM	VOLTMETER		
VMS	VARIABLE MESSAGE SIGN, VISUAL MESSAGING SYSTEM		
VMTF	VIBRATION MITIGATION TRACK FORM		
VOL	VOLUME		
VOX	VOICE OPERATED TRANSMITTER		
VPI	GENERAL RAILWAY SIGNAL'S VITAL PROCESSOR INTERLOCKING SYSTEM		
VR	SPEED CODE APPLICATION RELAY, VIDEO REPEATER		
VRD	VITAL RELAY DRIVER, VPI VITAL RELAY DRIVER RELAY		
VRD01R	FIRST REPEATER OF VRD		
VS	VOLTMETER SWITCH		
VSC	VITAL SERIAL CONTROLLER		
VT	VOLTMETER TRANSDUCER, VOLTAGE TRANSFORMER		
VTR	VENT THRU ROOF		
VZ	VENT ZONE		

W	WIDTH, WATER, WEST, WATT		
W/	WITH		
W/O	WITHOUT		
WAC	WALL MOUNTED AIR CONDITIONING UNIT		
WAO	WORK AREA OUTLET		
WB	WESTBOUND, WEST BANK, WET BULB		
WC	WATER CLOSET		
WCO	WALL CLEAN OUT		
W.PR.	WATER COLUMN		
WDG	WINDING		
WDM	WAVE DIVISION MULTIPLEXER		
WEG	WALL EXHAUST GRILLE		
WG	WATER GAUGE, WAVEGUIDE		
WGT	WEIGHT		
WGV	WATER GATE VALVE		
WH	WEEP HOLE, WATER HEATER		
WHA	WATER HAMMER ARRESTOR		
WIDS	WAYSIDE INTRUSION DETECTION SYSTEM		
WL	WALL LOUVER, WATER LINE		
W'LY	WESTERLY		
WM	WATER MAIN, WATER METER		
WMH	WATER MANHOLE		
WMS	WIRE MESH SCREEN		
WO	WHERE OCCURS, WASTE OIL REEL		
WP	WORK POINT, WEATHER PROOF		
WPF	WATERPROOF, WATERPROOFING		
WR	SWITCH CONTROL RELAY		
WRG	WALL RETURN GRILLE		
WRR	WALL RETURN REGISTER		
WSP	WELDED STEEL PIPE, WET STANDPIPE		
WSR	WALL SUPPLY REGISTER		
WSX	WARM SPRINGS EXTENSION		
WT	WEIGHT		
WTG	WALL TRANSFER GRILLE		
WTM	WAYSIDE TRIP MODULE		
WV	WATER VALVE		
WW	WIREWAY, WING WALL		
WWF	WELDED WIRE FABRIC		

--	--	
B:\Perez

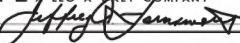					DESIGNED BY R. BANKS		Skanska Shimmick Herzog	1436 California Circle Milpitas, California 95035 A Joint Venture		Lockwood, Andrews & Newnam, Inc. A LEO A DALY COMPANY			LINE, TRACK, STATIONS, AND SYSTEMS	CADD FILENAME C700-S-RR-X233.dwg			
					DRAWN BY M. HALL									SIZE SCALE D NOT TO SCALE	CONTRACT NO. C700		REV. 0
					CHECKED BY D. CLARY												
					IN CHARGE K. ANDERSON												
0	20121102				READY FOR CONSTRUCTION	DATE 20121102	SUBMITTED 	APPROVED 	GENERAL ABBREVIATIONS SHEET 4 OF 4					AREA CODE RR	SHEET NO. X233	PAGE NO. 0006	

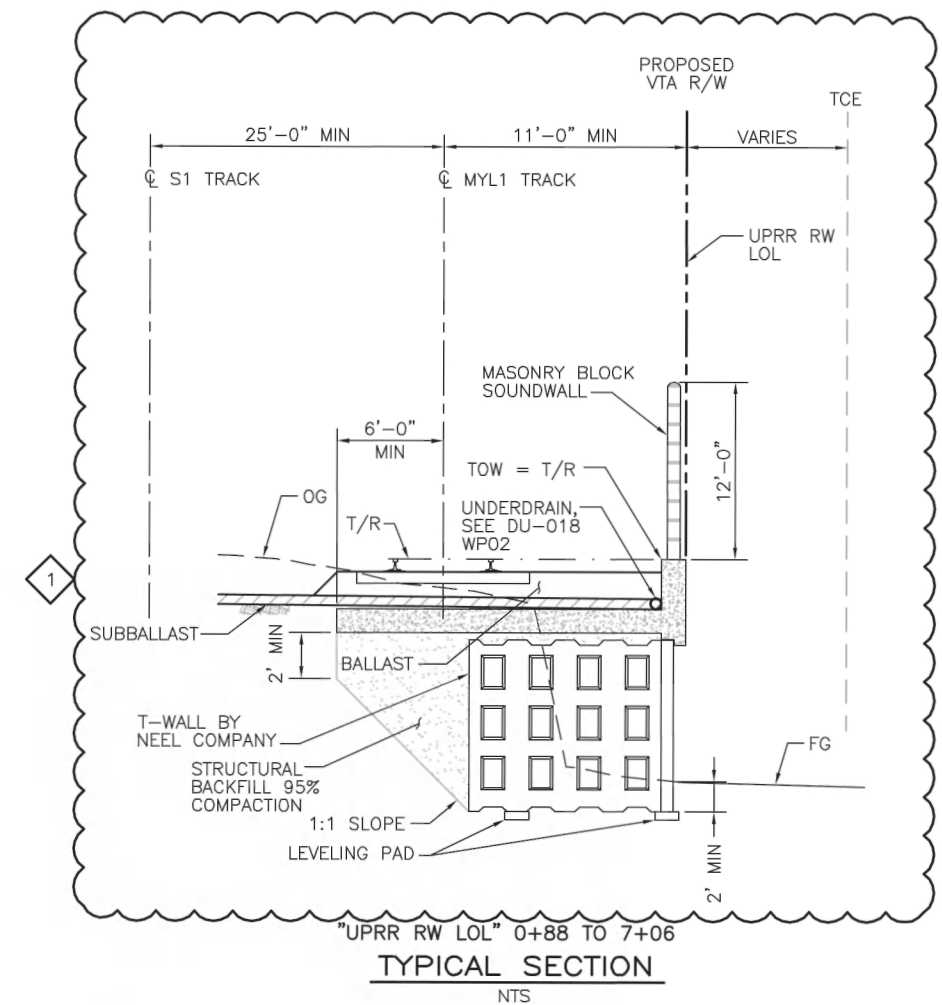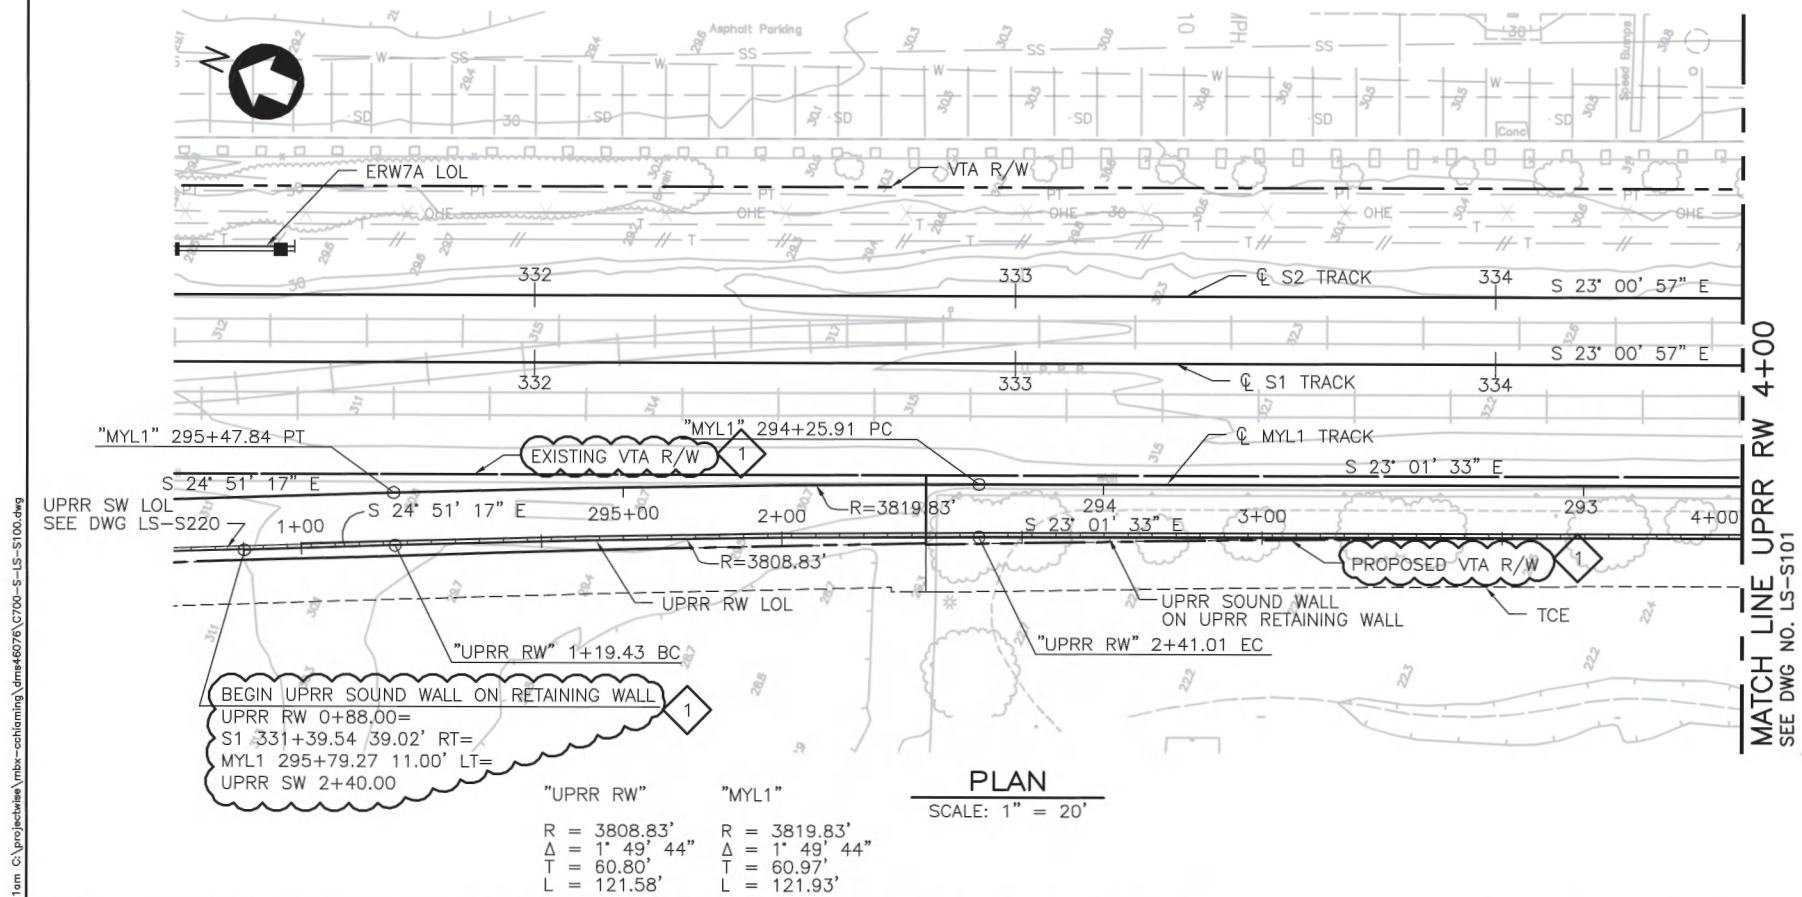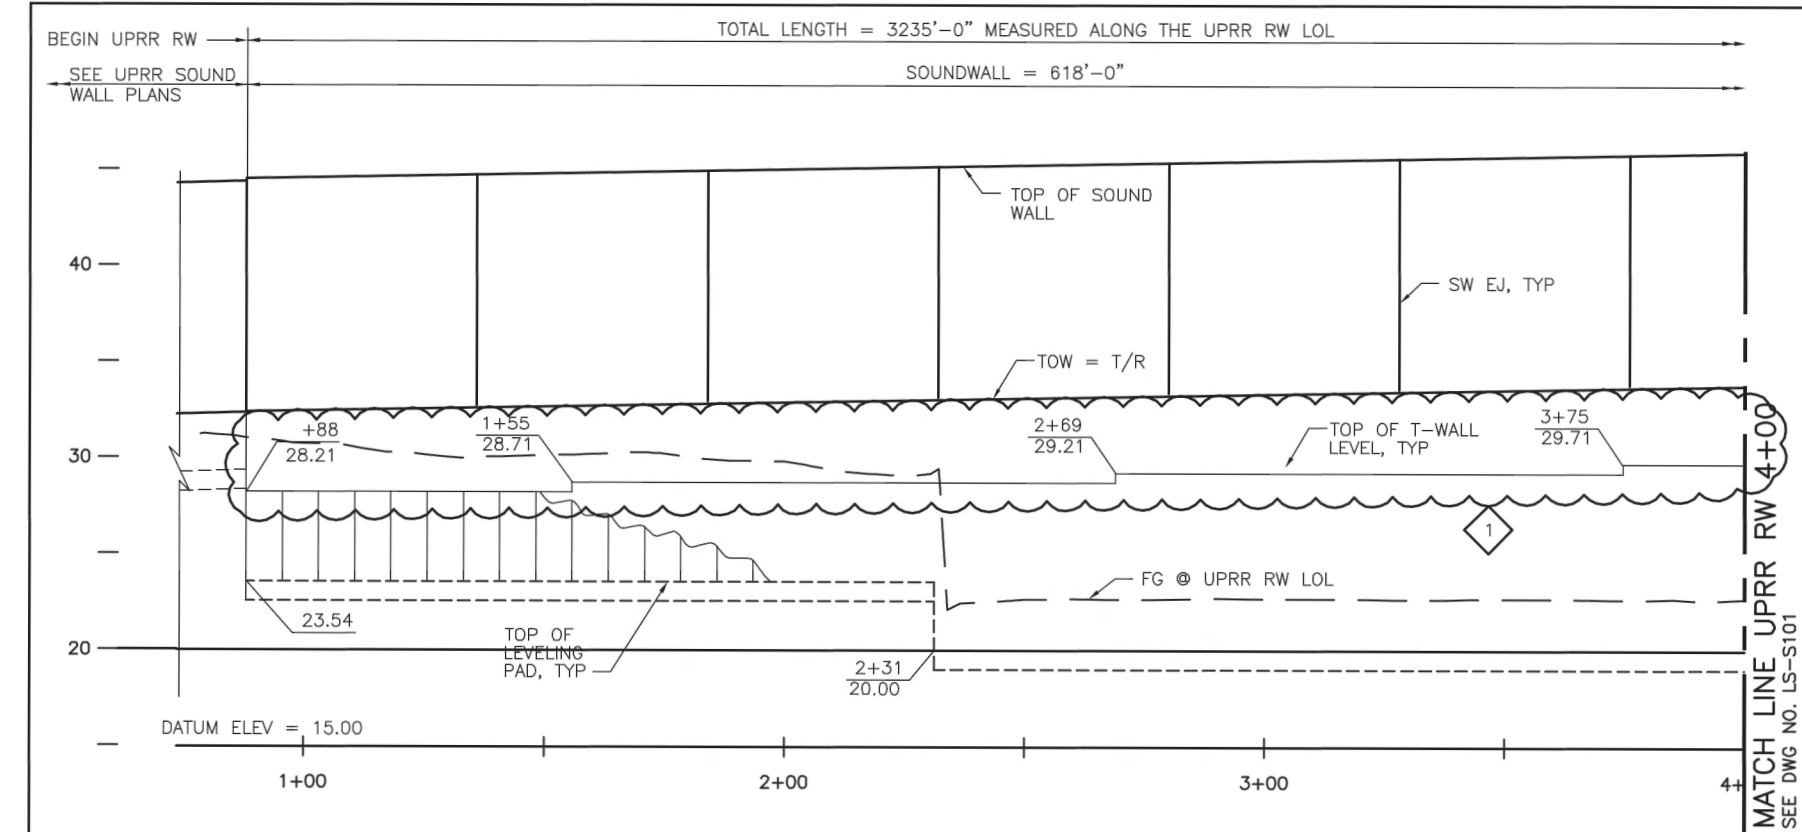

NOTES:

1. FOR SOUNDWALL DETAILS SEE SHEET S110.
2. CONTRACTOR SHALL PROTECT EXISTING UTILITIES.
3. SUBGRADE WILL BE VERIFIED BY GEOTECHNICAL ENGINEER OF RECORD OR DESIGNEE.
4. THE MAJORITY OF THE SETTLEMENT IS EXPECTED TO OCCUR DURING THE EARTH WORK AND THE CONSTRUCTION OF THE T-WALLS. A WAITING PERIOD OF 15 DAYS IS RECOMMENDED AFTER THE WALLS ARE COMPLETED TO MINIMIZE POTENTIAL SETTLEMENT. SETTLEMENT SHOULD BE VERIFIED AT LEAST WITH SURVEY RESULTS. THE RECOMMENDED 15-DAY WAITING PERIOD MAY BE SHORTENED BASED ON THE SETTLEMENT MONITORING RESULTS AFTER REVIEWED BY THE GEOTECHNICAL ENGINEER OF RECORD PRIOR TO THE CONSTRUCTION OF THE TRACKS.
5. FOR TRACK DETAILS SEE DU-018 WP02.

Santa Clara Valley Transportation Authority

- ✓ NO EXCEPTIONS TAKEN (NET)
MAKE CORRECTIONS NOTED (MCN)
AMEND AND RESUBMIT (A/R)

Any action shown above is subject to the terms of the contract and does not relieve the Contractor of any of its obligations under the contract, including design and detailing.

Contract No.: DBI1002F


By: *[Signature]* Date: 7/1/13

20' 0' 20' 40'

GRAPHIC SCALE

REV	DATE	BY	SUB	APP	DESCRIPTION
1	20130416				RFC REV 1
0	20121116				READY FOR CONSTRUCTION

DESIGNED BY
C. SONG
DRAWN BY
C. CHI
CHECKED BY
R. KWOK
IN CHARGE
O. LI
DATE
20130416

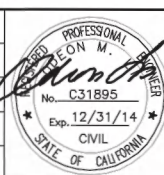

Skanska
Shimmick
Herzog

1436 California Circle
Milpitas, California 95035
A Joint Venture

T.Y. LIN INTERNATIONAL

Lookwood, Andrews
& Newman, Inc.
A LEI A BART COMPANY

T.Y. LIN INTERNATIONAL

SUBMITTED *[Signature]* APPROVED *[Signature]*




LINE, TRACK, STATIONS AND SYSTEMS

UPRR RETAINING WALL
GENERAL PLAN NO. 1
SHEET 1 OF 8


CADD FILENAME C700-S-LS-S100.dwg	SIZE D	SCALE AS NOTED
CONTRACT NO. C700	SHEET NO. S100	REV. 1
AREA CODE LS	PAGE NO. 0007	


Jun 13, 2013 10:49am C:\projects\ss\ss-civil\ss-civil\ss-civil.dwg


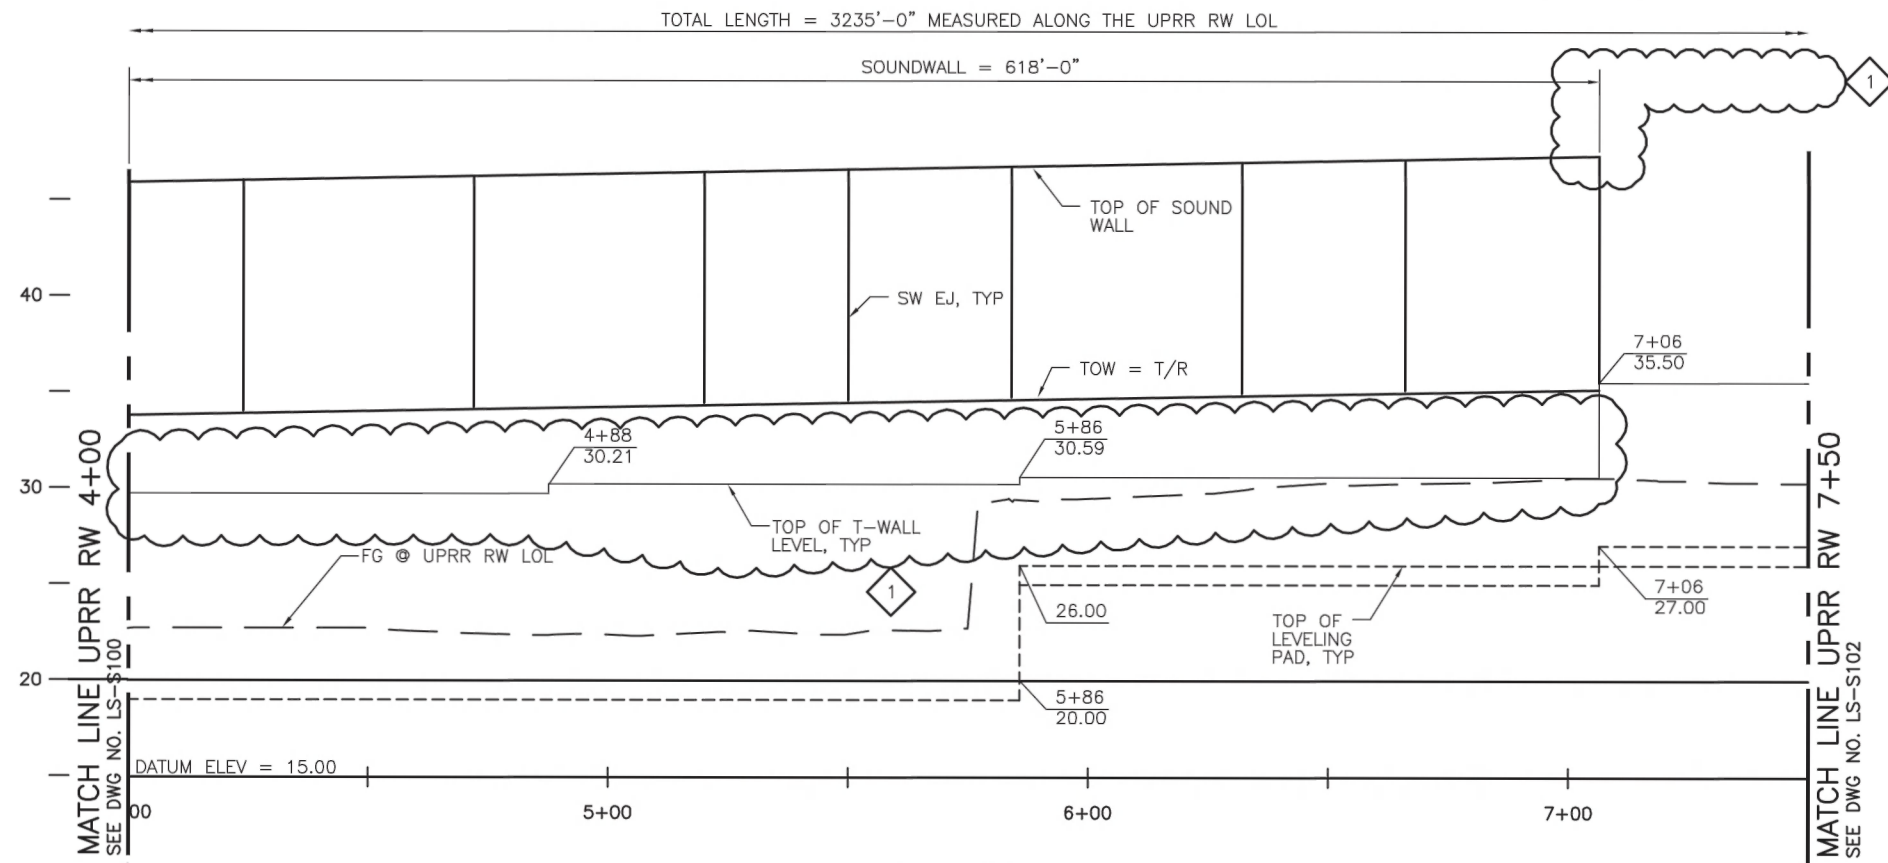


ELEVATION

SCALE: 1" = 20' (H)
1" = 5' (V)

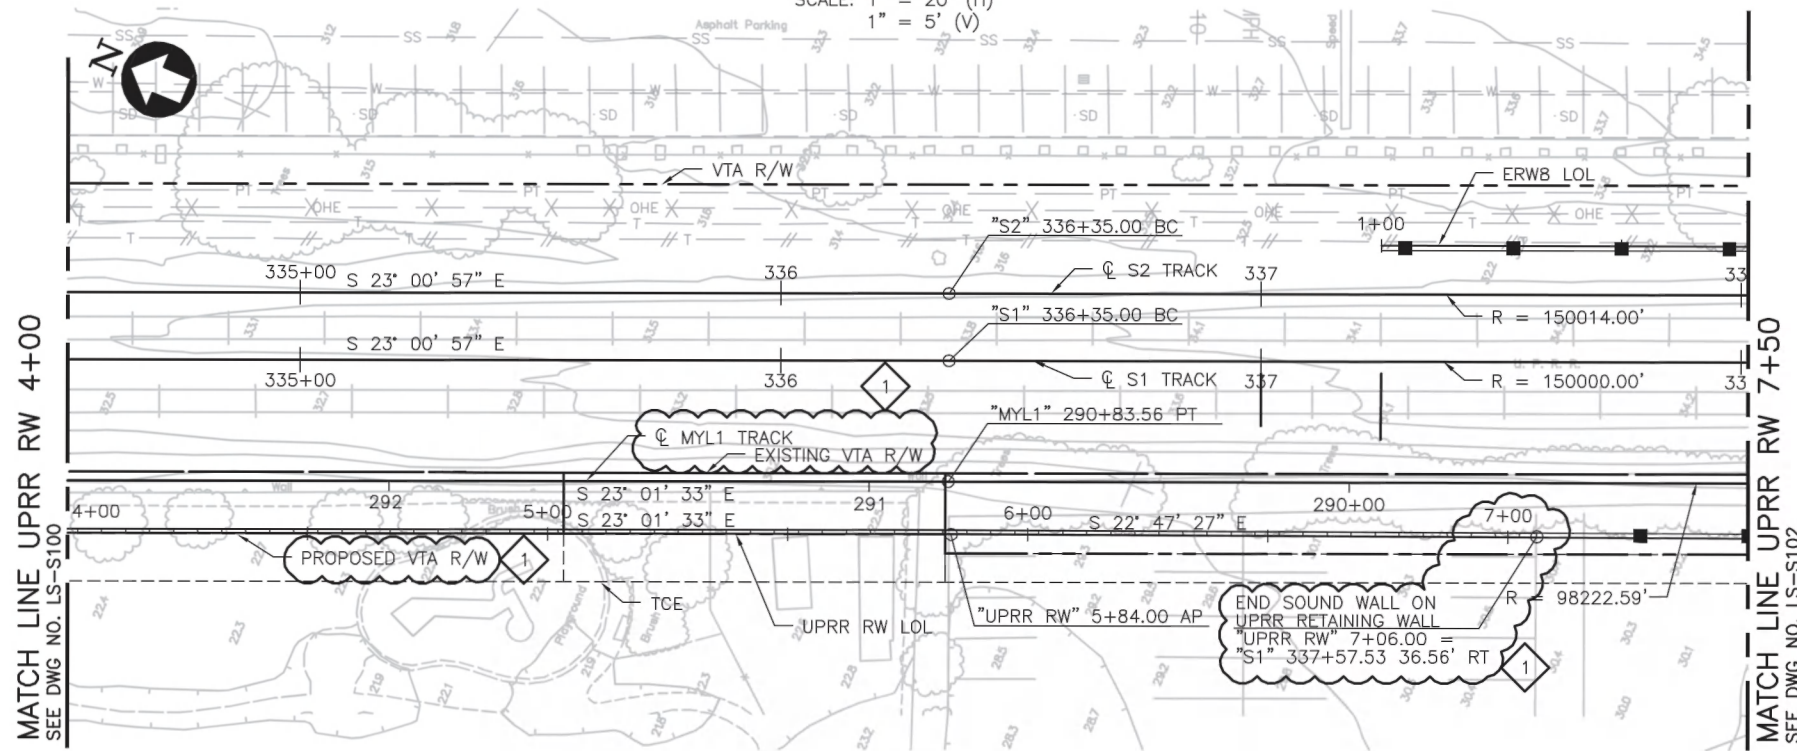

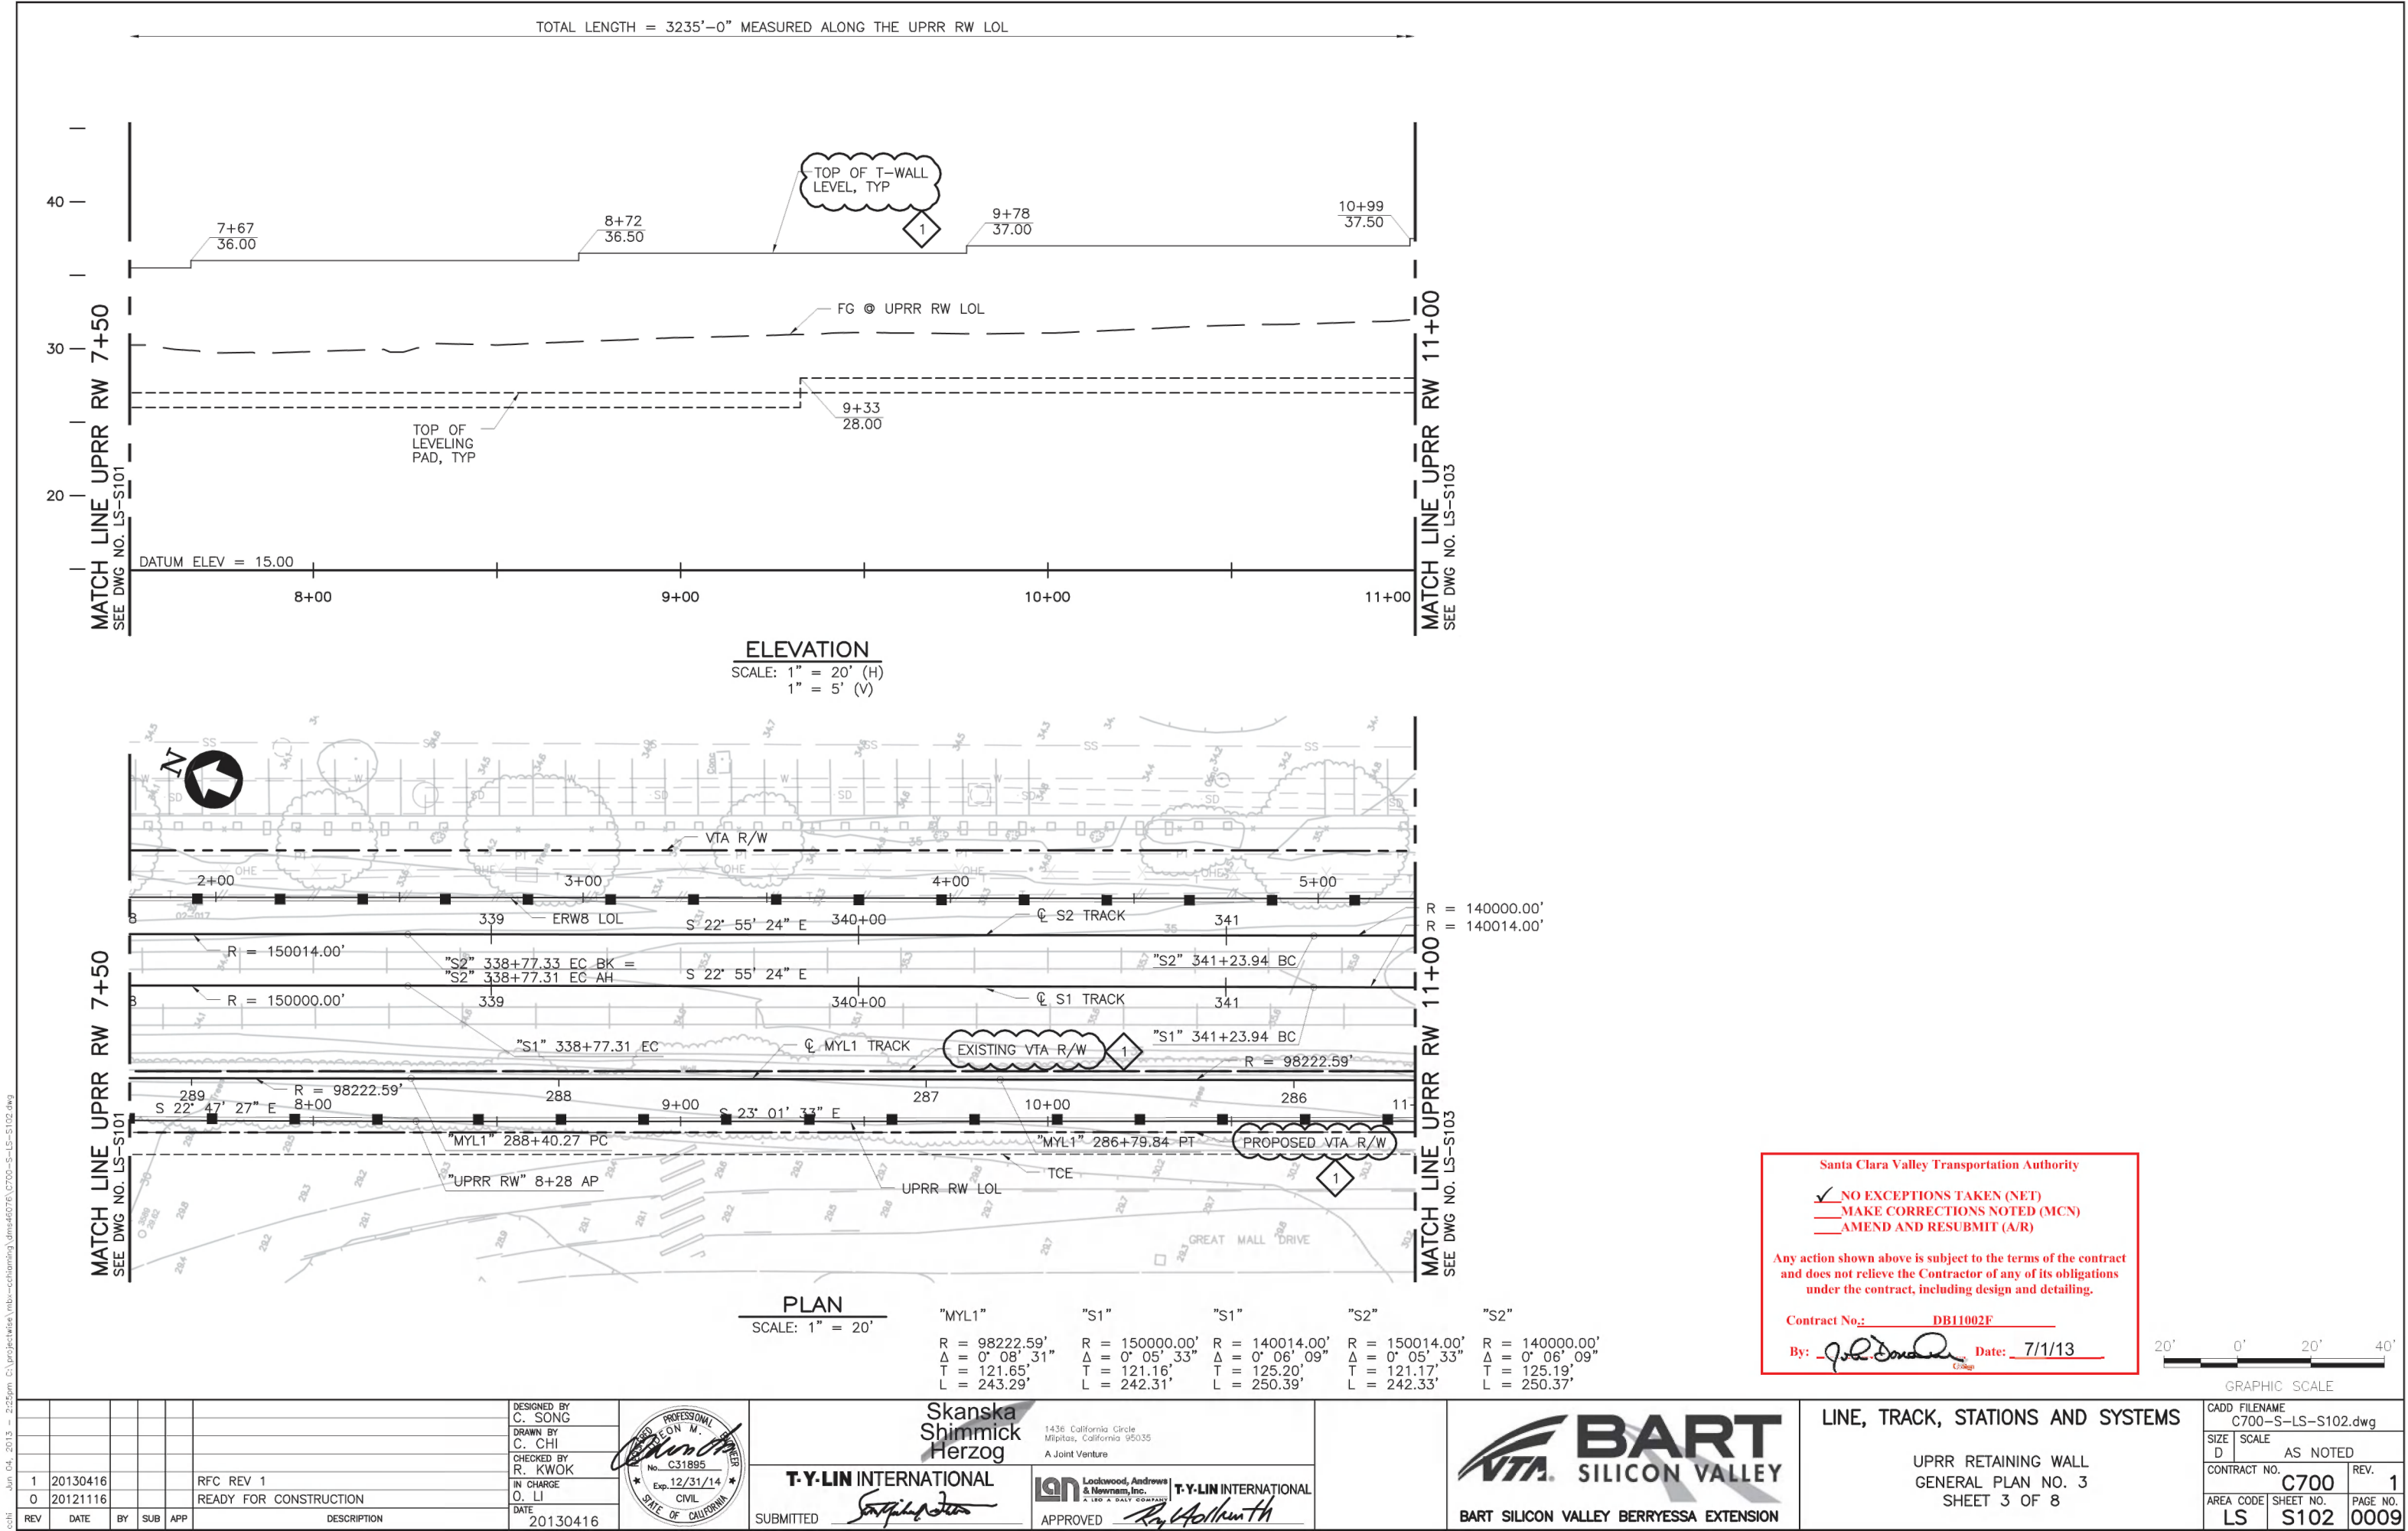

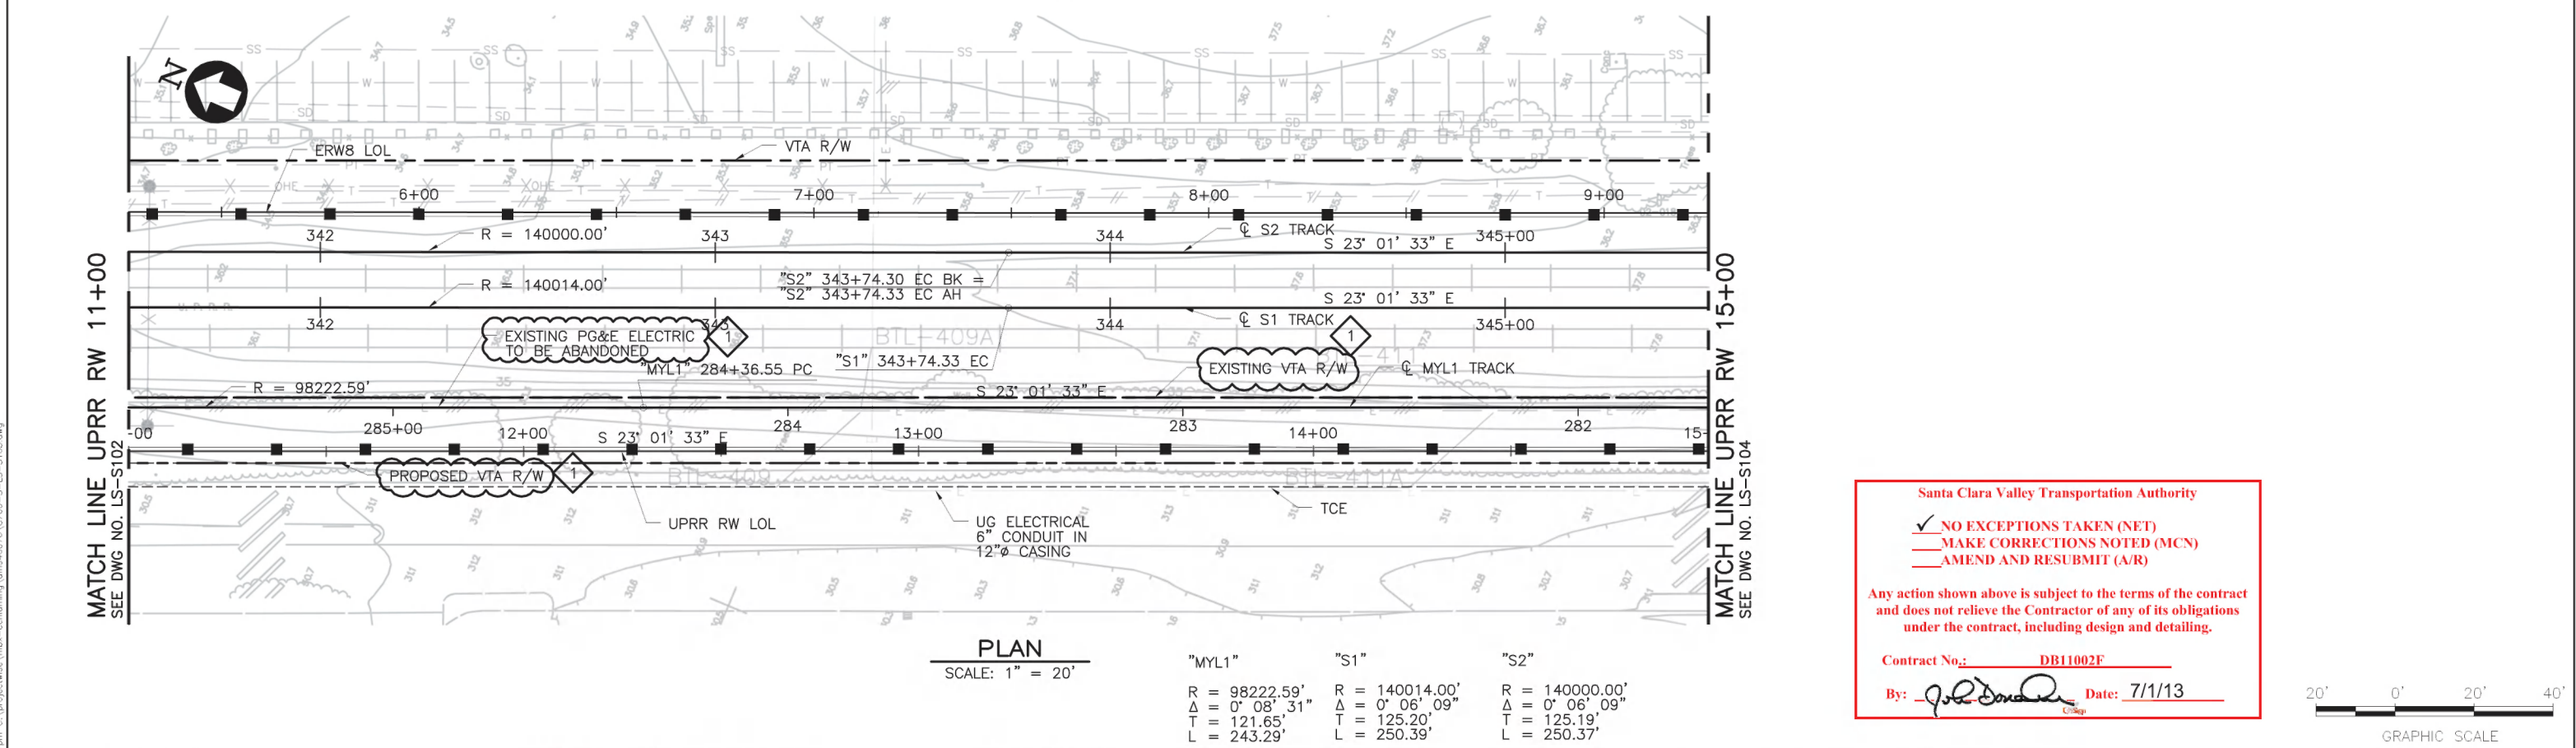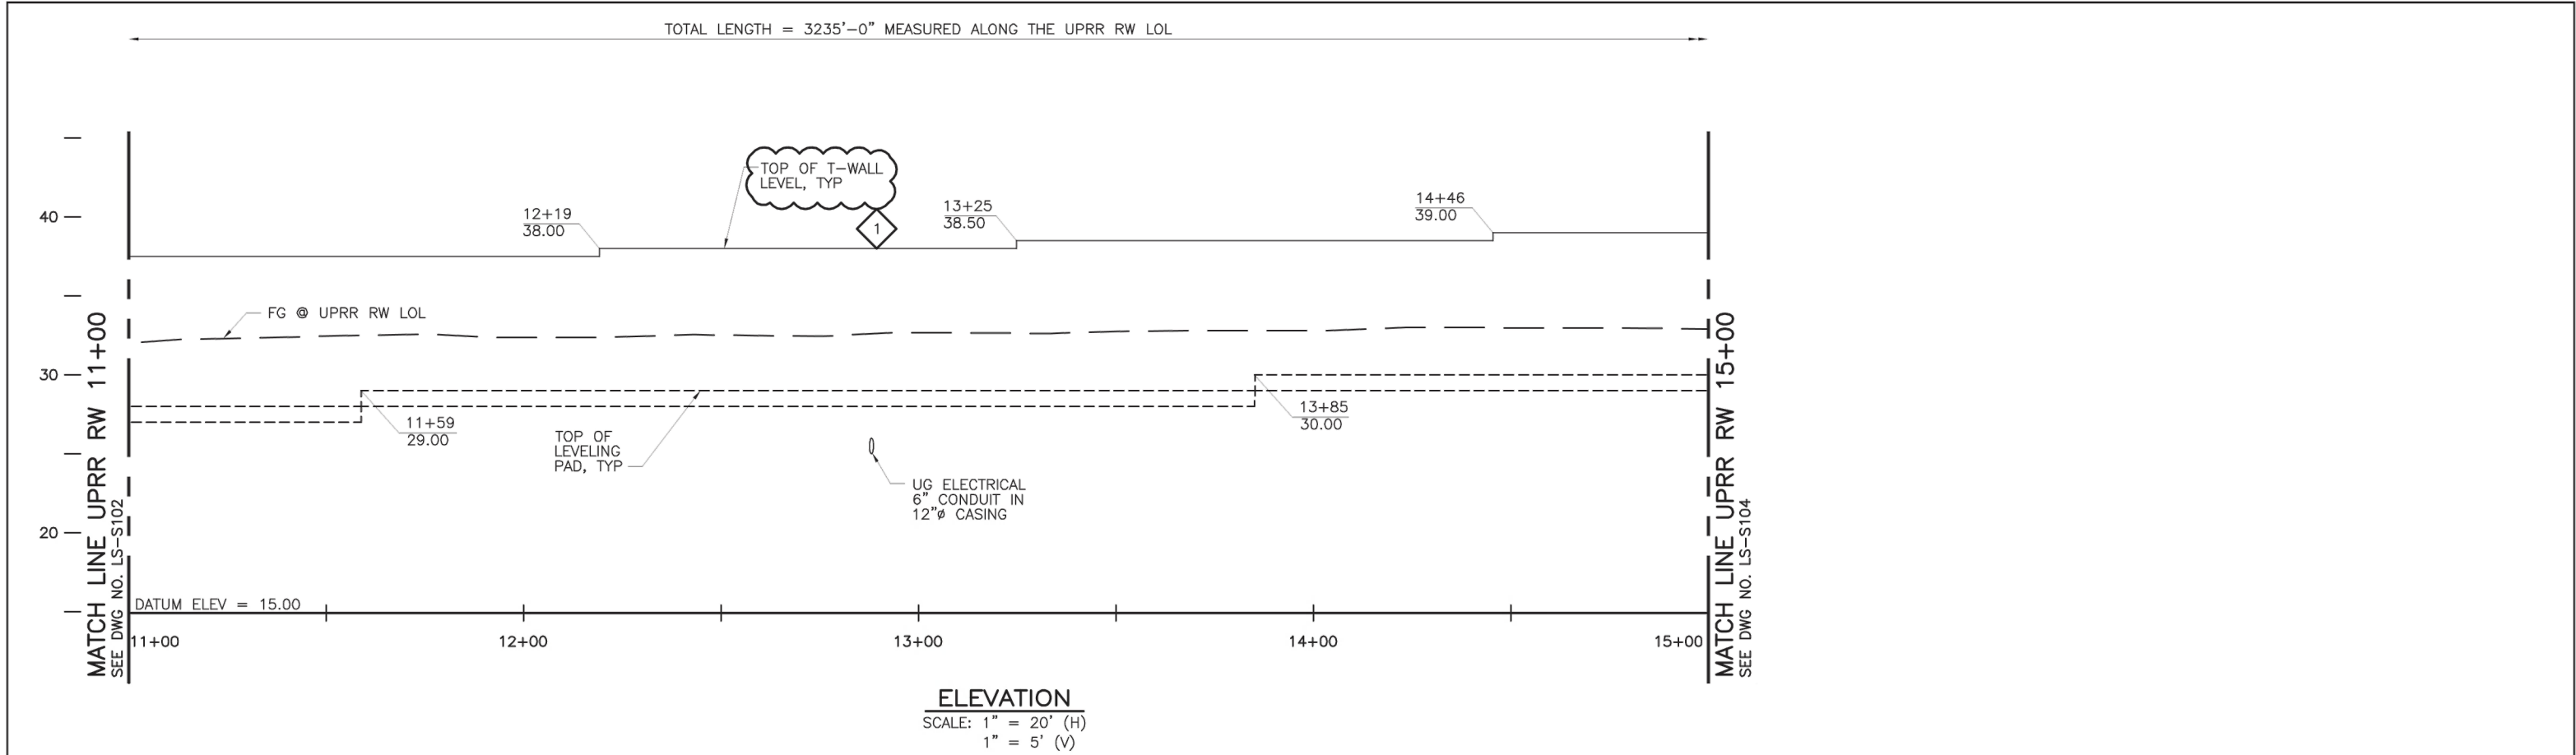

Santa Clara Valley Transportation Authority

☒ NO EXCEPTIONS TAKEN (NET)
☐ MAKE CORRECTIONS NOTED (MCN)
☐ AMEND AND RESUBMIT (A/R)

Any action shown above is subject to the terms of the contract and does not relieve the Contractor of any of its obligations under the contract, including design and detailing.


Contract No.: DB11002F

By: [Signature] Date: 7/1/13




--	--	
Jun 04 2013 2:27pm C:\projects\ls-s103\ls-s103.dwg

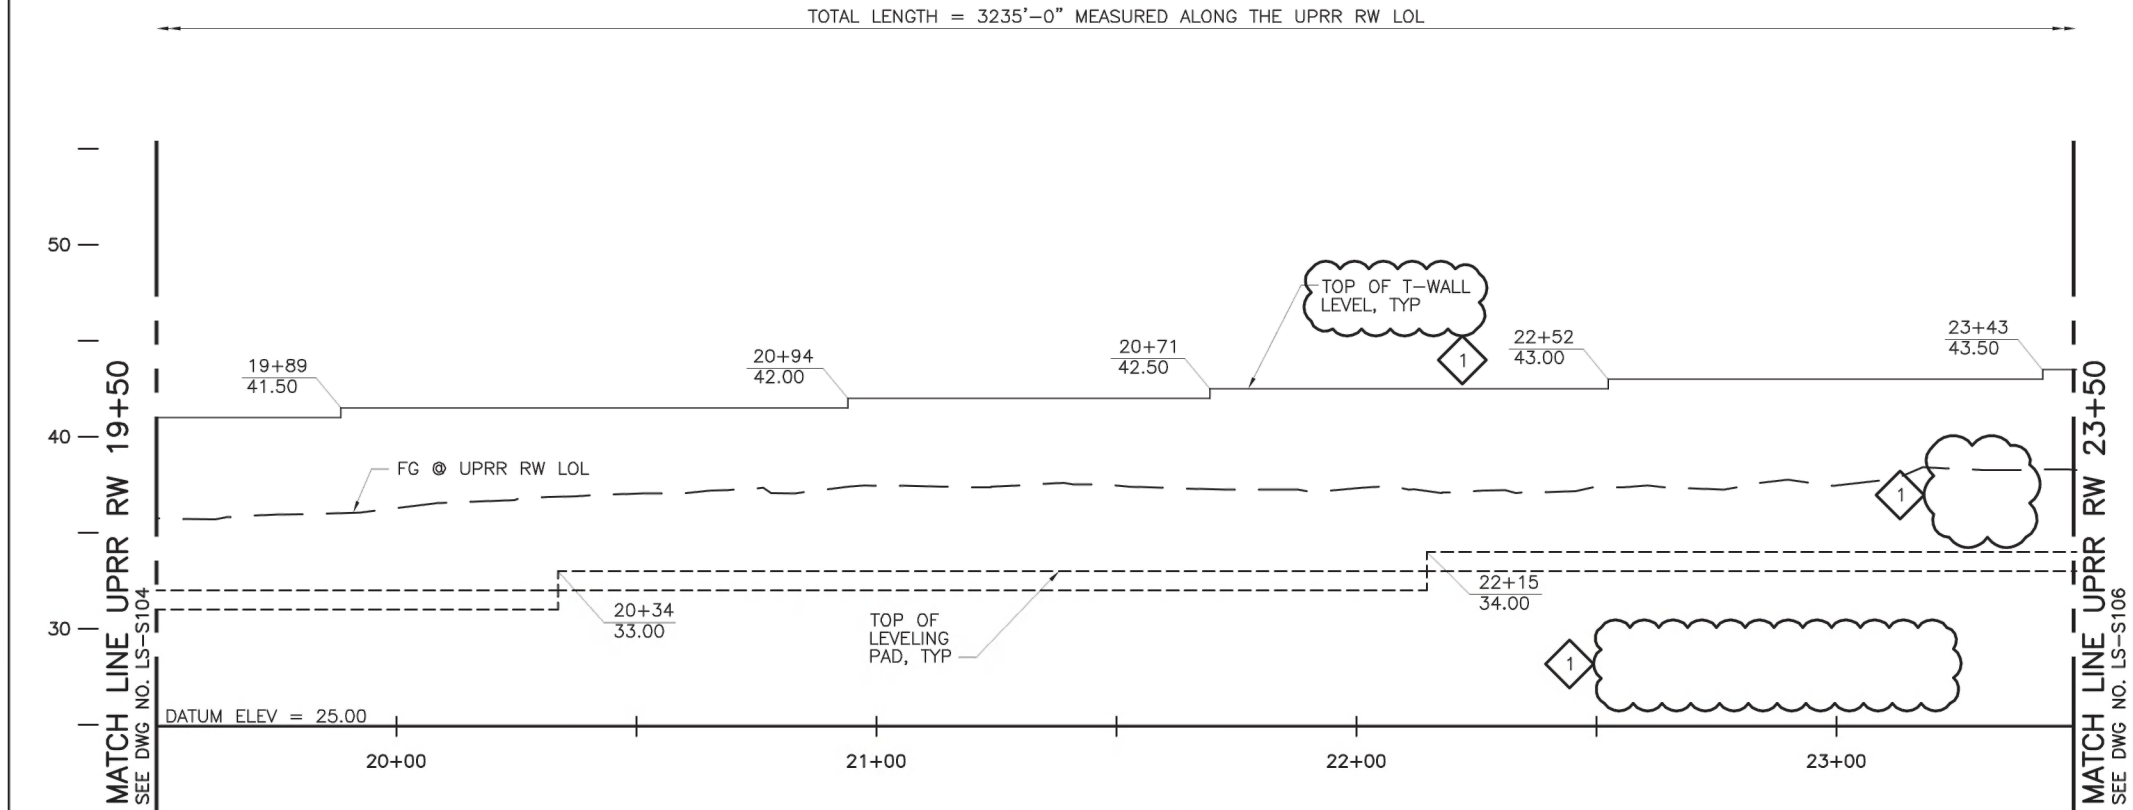

ELEVATION
SCALE: 1" = 20' (H)
1" = 5' (V)

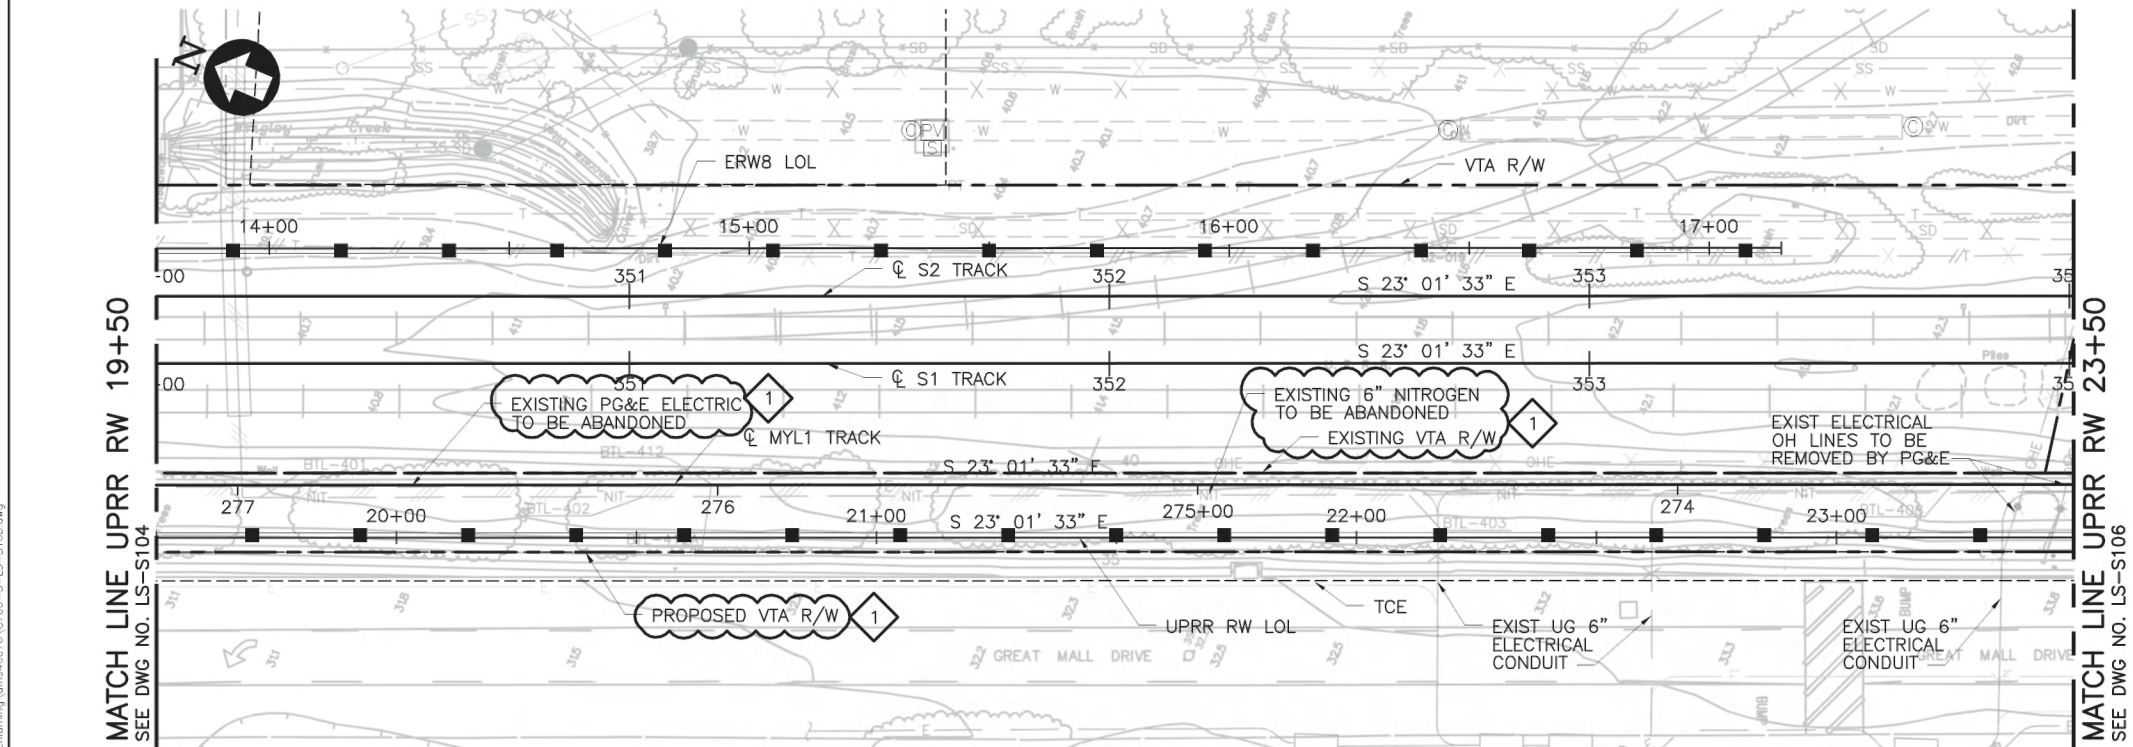

PLAN
SCALE: 1" = 20'


Santa Clara Valley Transportation Authority

✓ NO EXCEPTIONS TAKEN (NET)
— MAKE CORRECTIONS NOTED (MCN)
— AMEND AND RESUBMIT (A/R)

Any action shown above is subject to the terms of the contract and does not relieve the Contractor of any of its obligations under the contract, including design and detailing.

Contract No.: DB11002F

By: *[Signature]* Date: 7/1/13

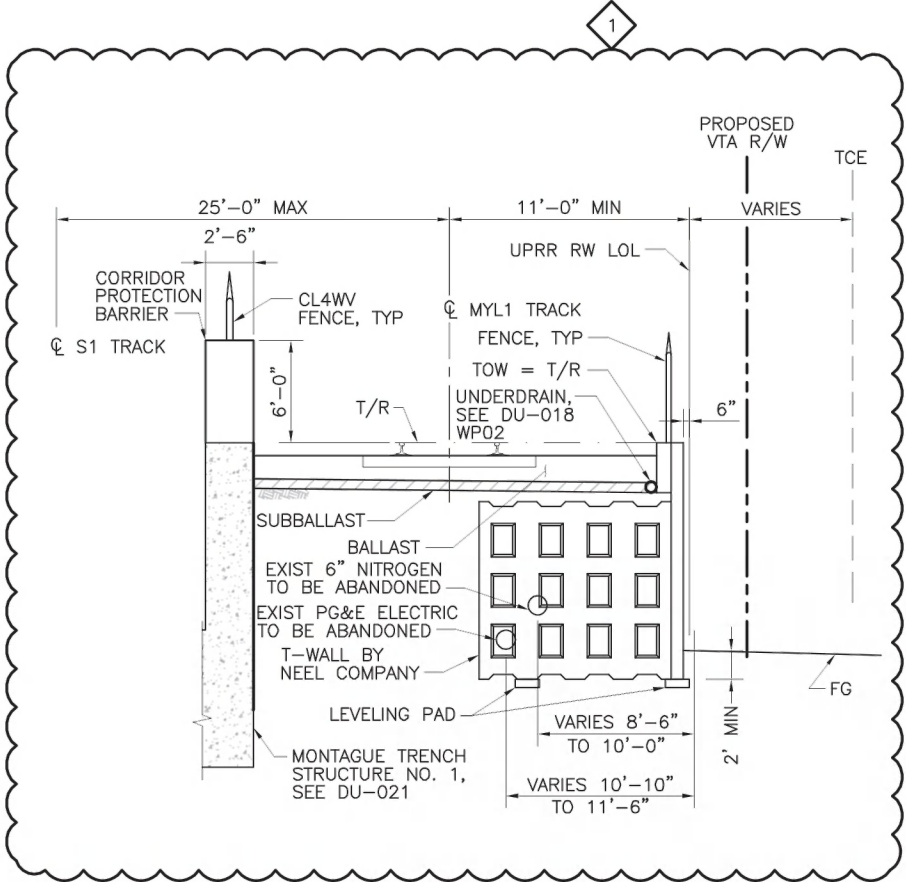

"UPRR RW LOL" 22+88.50 TO 32+11
TYPICAL SECTION
NTS



DESIGNED BY C. SONG DRAWN BY C. CHI CHECKED BY R. KWOK IN CHARGE O. LI DATE 20130416					Skanska Shimmick Herzog 1436 California Circle Milpitas, California 95035 A Joint Venture		Lookwood, Andrews & Nowman, Inc. A LEI A DAILY COMPANY		BART SILICON VALLEY BART SILICON VALLEY BERRYESSA EXTENSION		LINE, TRACK, STATIONS AND SYSTEMS UPRR RETAINING WALL GENERAL PLAN NO. 6 SHEET 6 OF 8			CADD FILENAME C700-S-LS-S105.dwg SIZE D SCALE AS NOTED CONTRACT NO. C700 REV. 1 AREA CODE LS SHEET NO. S105 PAGE NO. 0012		
1	20130416				RFC REV 1		T-Y-LIN INTERNATIONAL									
0	20121116				READY FOR CONSTRUCTION		SUBMITTED		APPROVED							


Santa Clara Valley Transportation Authority

☒ **NO EXCEPTIONS TAKEN (NET)**
☐ **MAKE CORRECTIONS NOTED (MCN)**
☐ **AMEND AND RESUBMIT (A/R)**

Any action shown above is subject to the terms of the contract and does not relieve the Contractor of any of its obligations under the contract, including design and detailing.


Contract No.: DB11002F

By:  Date: 7/11/13

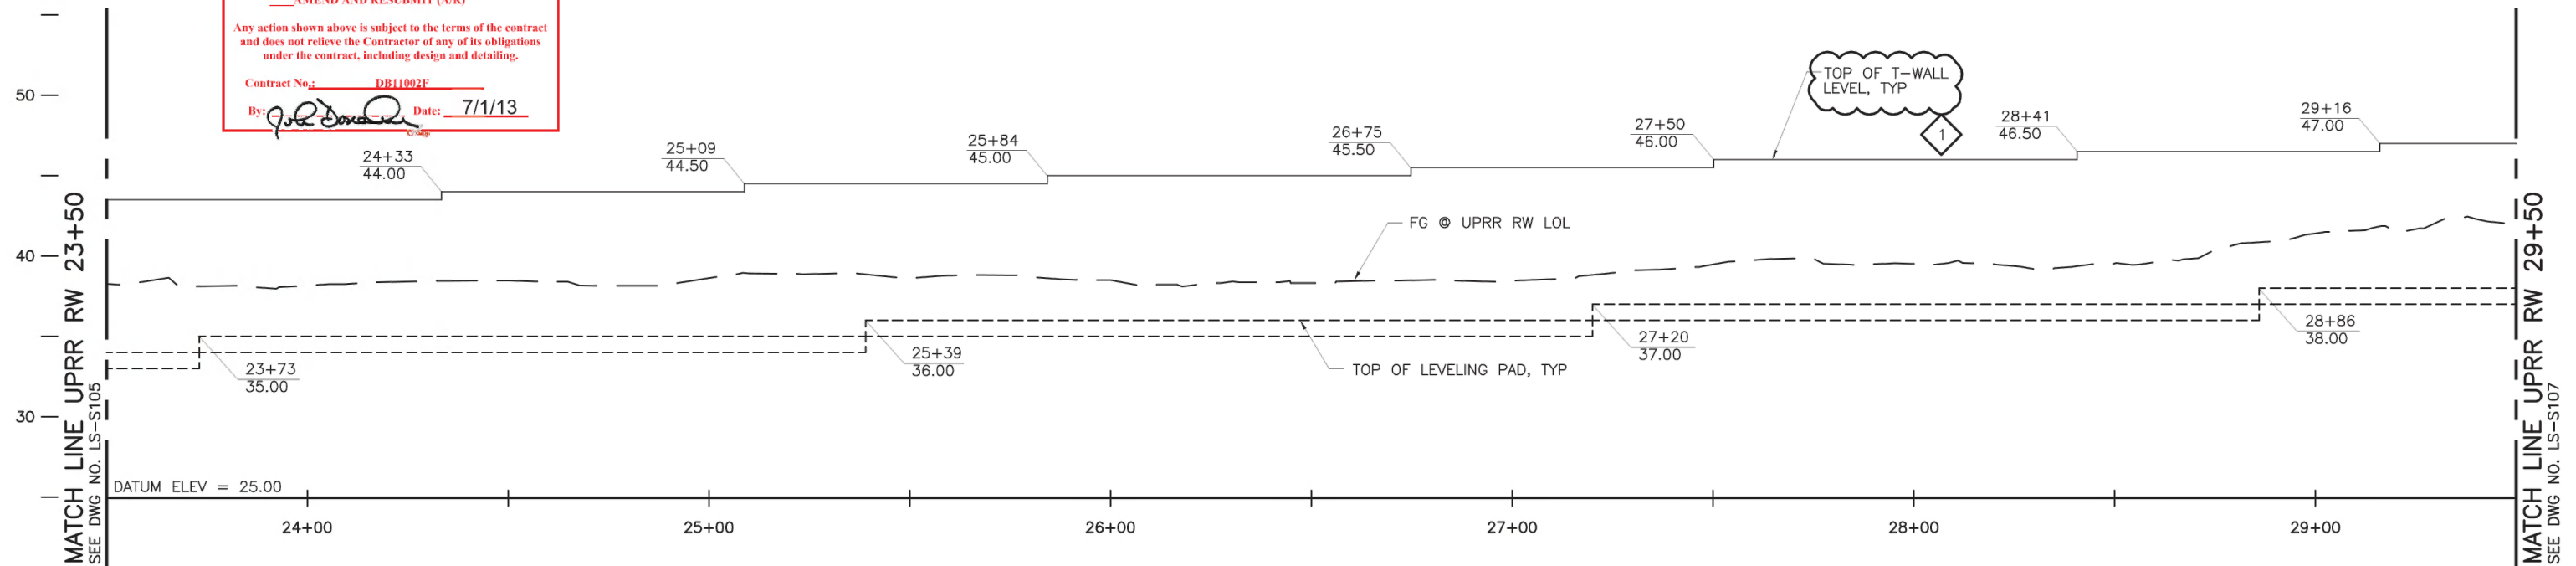


ELEVATION

SCALE: 1" = 20' (H)
1" = 5' (V)

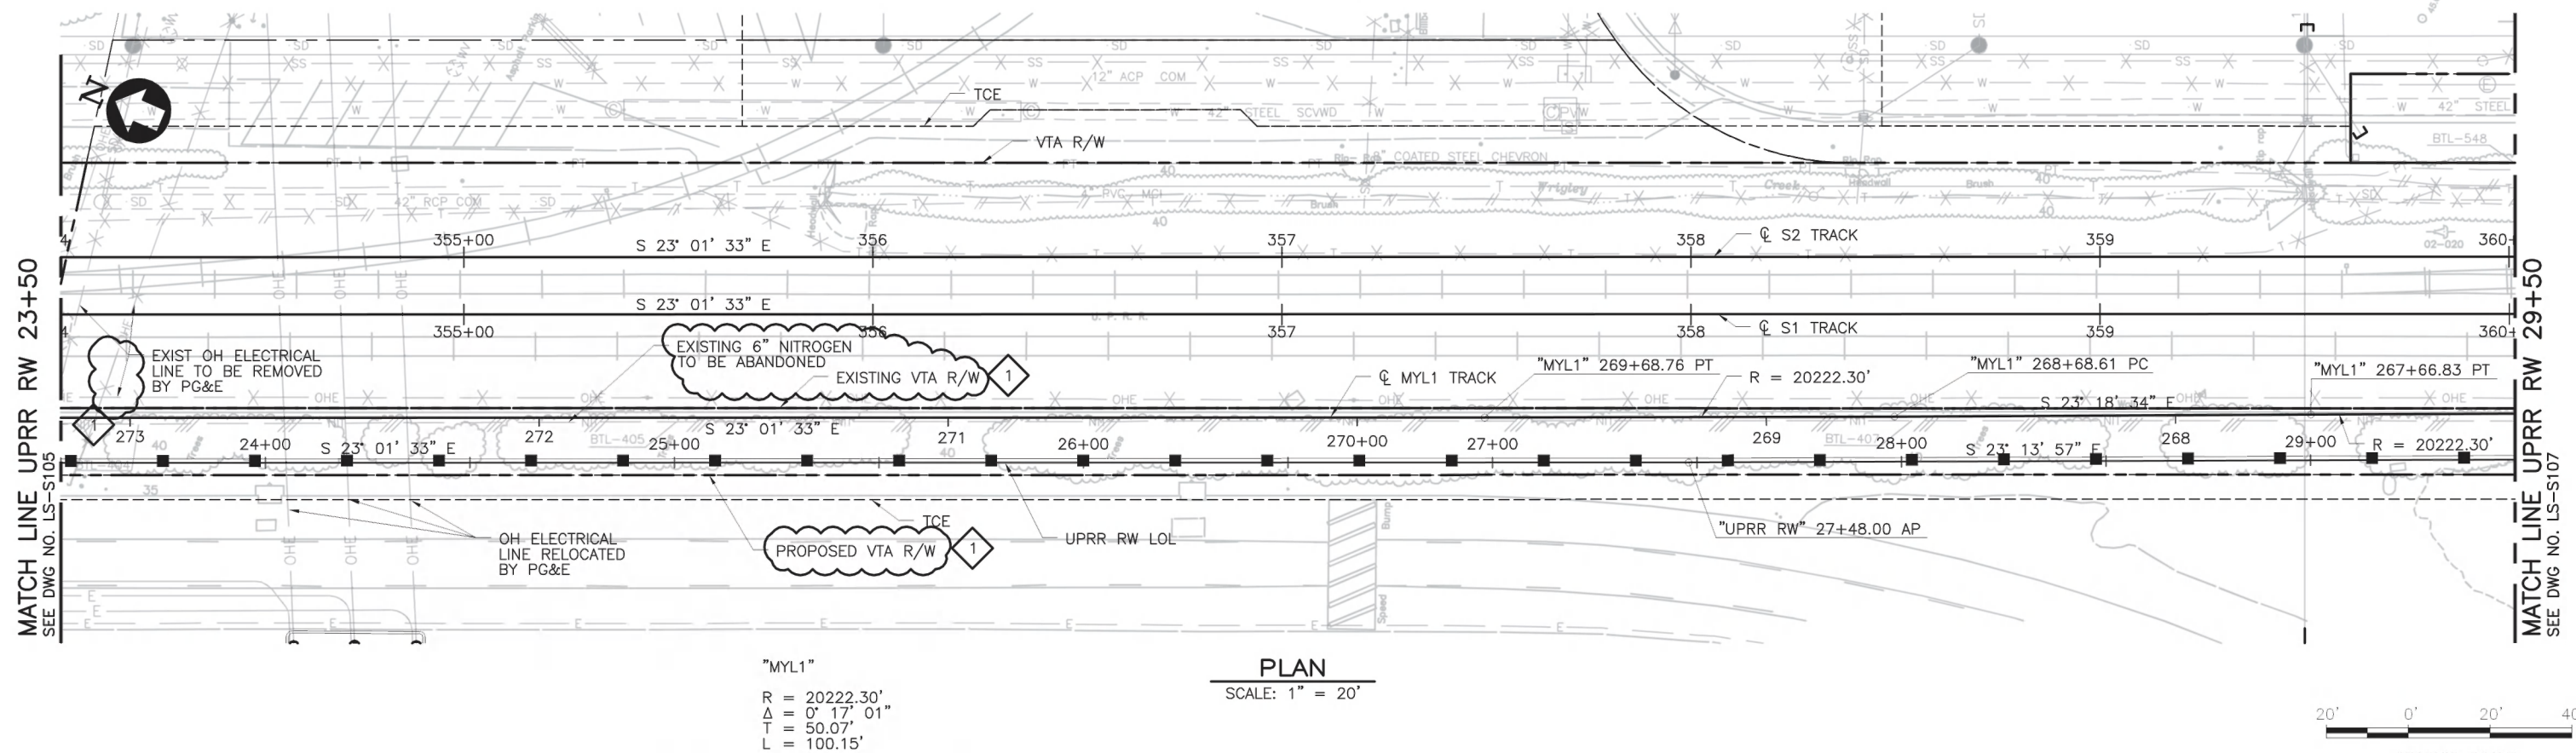

						DESIGNED BY C. SONG		Skanska Shimmick Herzog	1436 California Circle Milpitas, California 95035 A Joint Venture	 BART SILICON VALLEY BART SILICON VALLEY BERRYESSA EXTENSION	LINE, TRACK, STATIONS AND SYSTEMS	CADD FILENAME C700-S-LS-S106.dwg		
					DRAWN BY C. CHI	SIZE SCALE								
					CHECKED BY R. KWOK	D AS NOTED								
1	20130416				IN CHARGE O. LI	CONTRACT NO.						C700	REV.	1
0	20121116				DATE 20130416	AREA CODE						LS	SHEET NO.	S106
REV	DATE	BY	SUB	APP	DESCRIPTION	STATE OF CALIFORNIA							PAGE NO.	0013

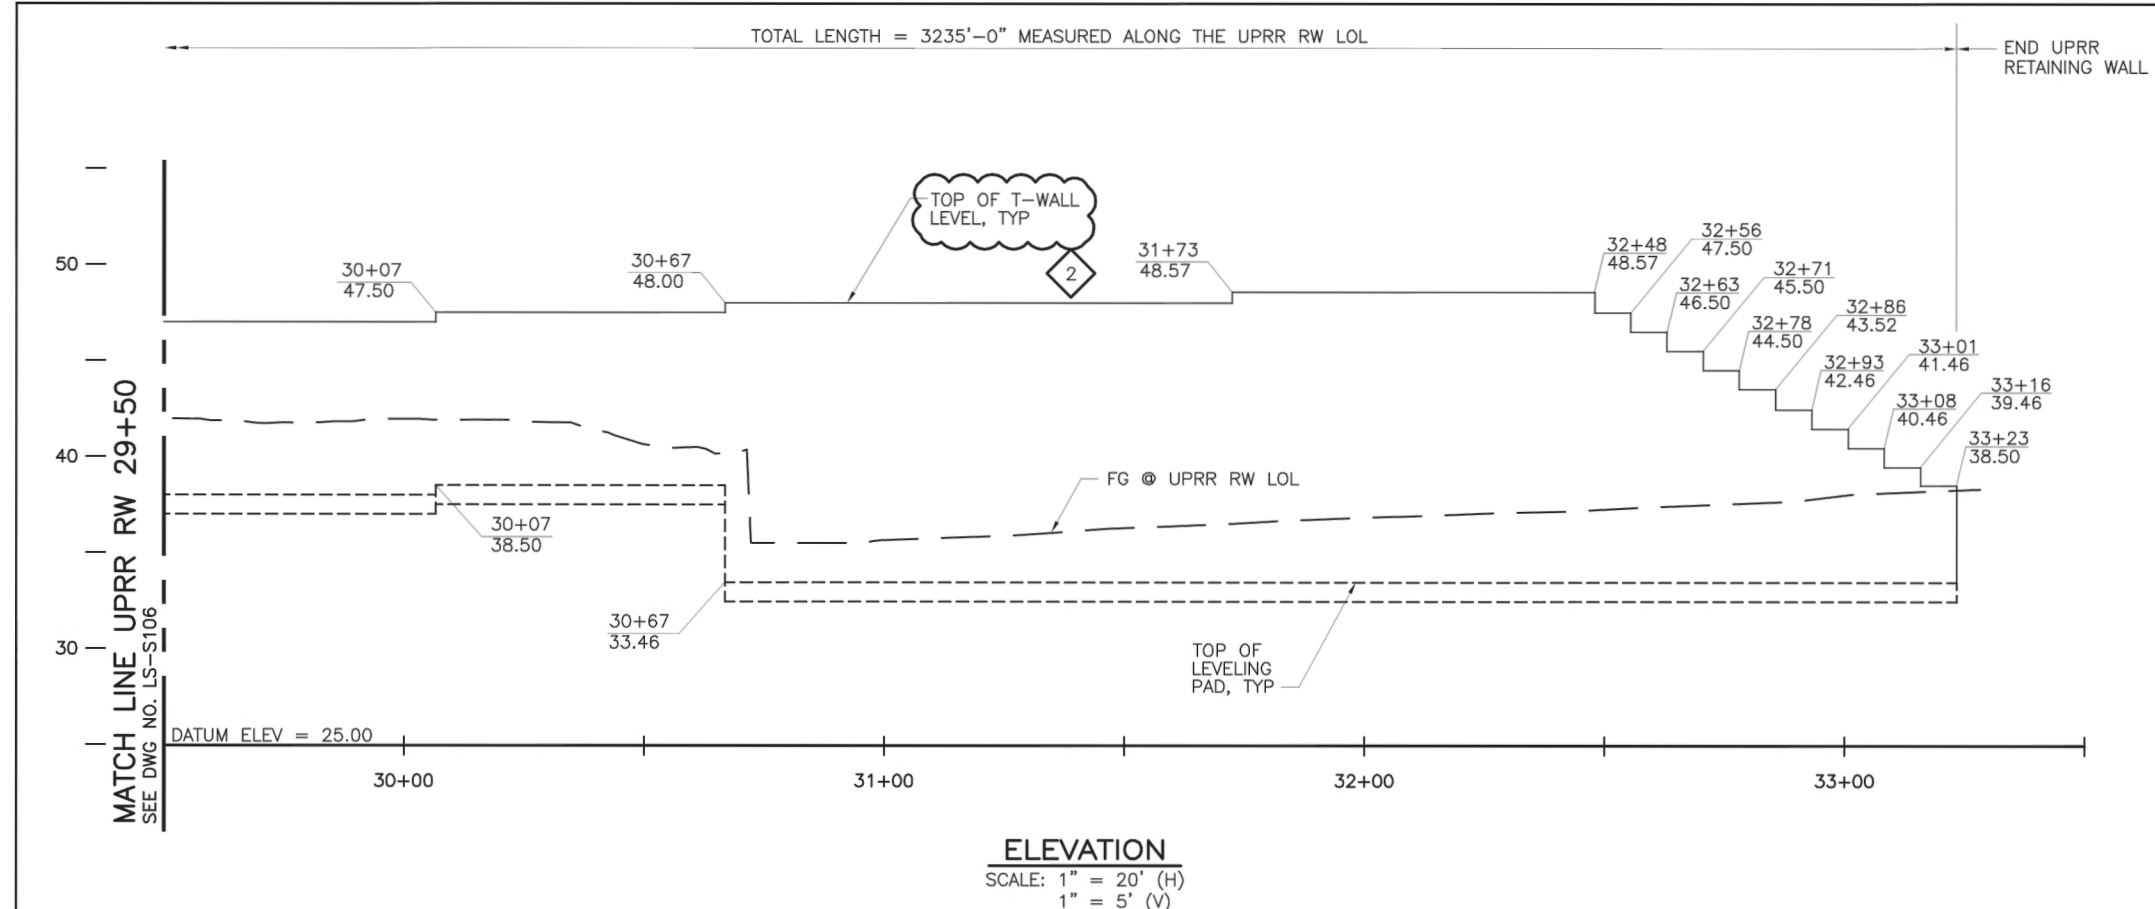


Santa Clara Valley Transportation Authority

✓ NO EXCEPTIONS TAKEN (NET)
— MAKE CORRECTIONS NOTED (MCN)
— AMEND AND RESUBMIT (A/R)



Any action shown above is subject to the terms of the contract and does not relieve the Contractor of any of its obligations under the contract, including design and detailing.

Contract No.: DB11002F

By: *[Signature]* Date: 7/1/13

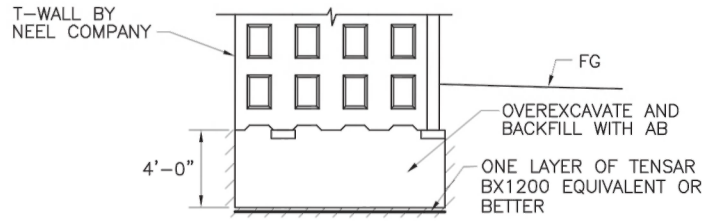

"UPRR RW LOL" 30+67 TO 33+23
GROUND IMPROVEMENT
NTS

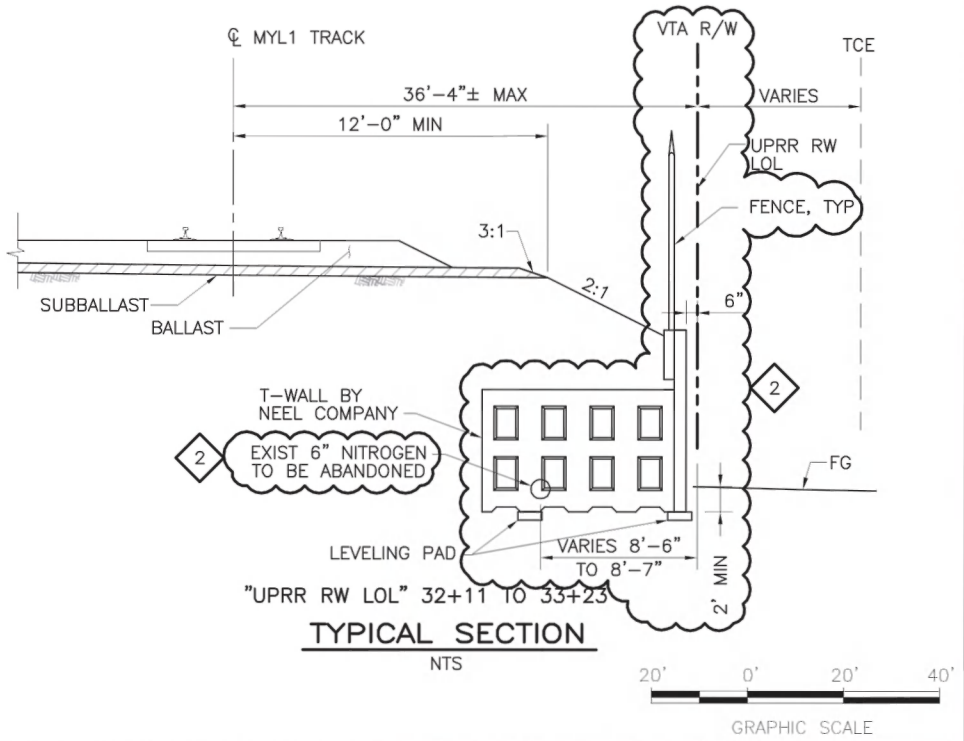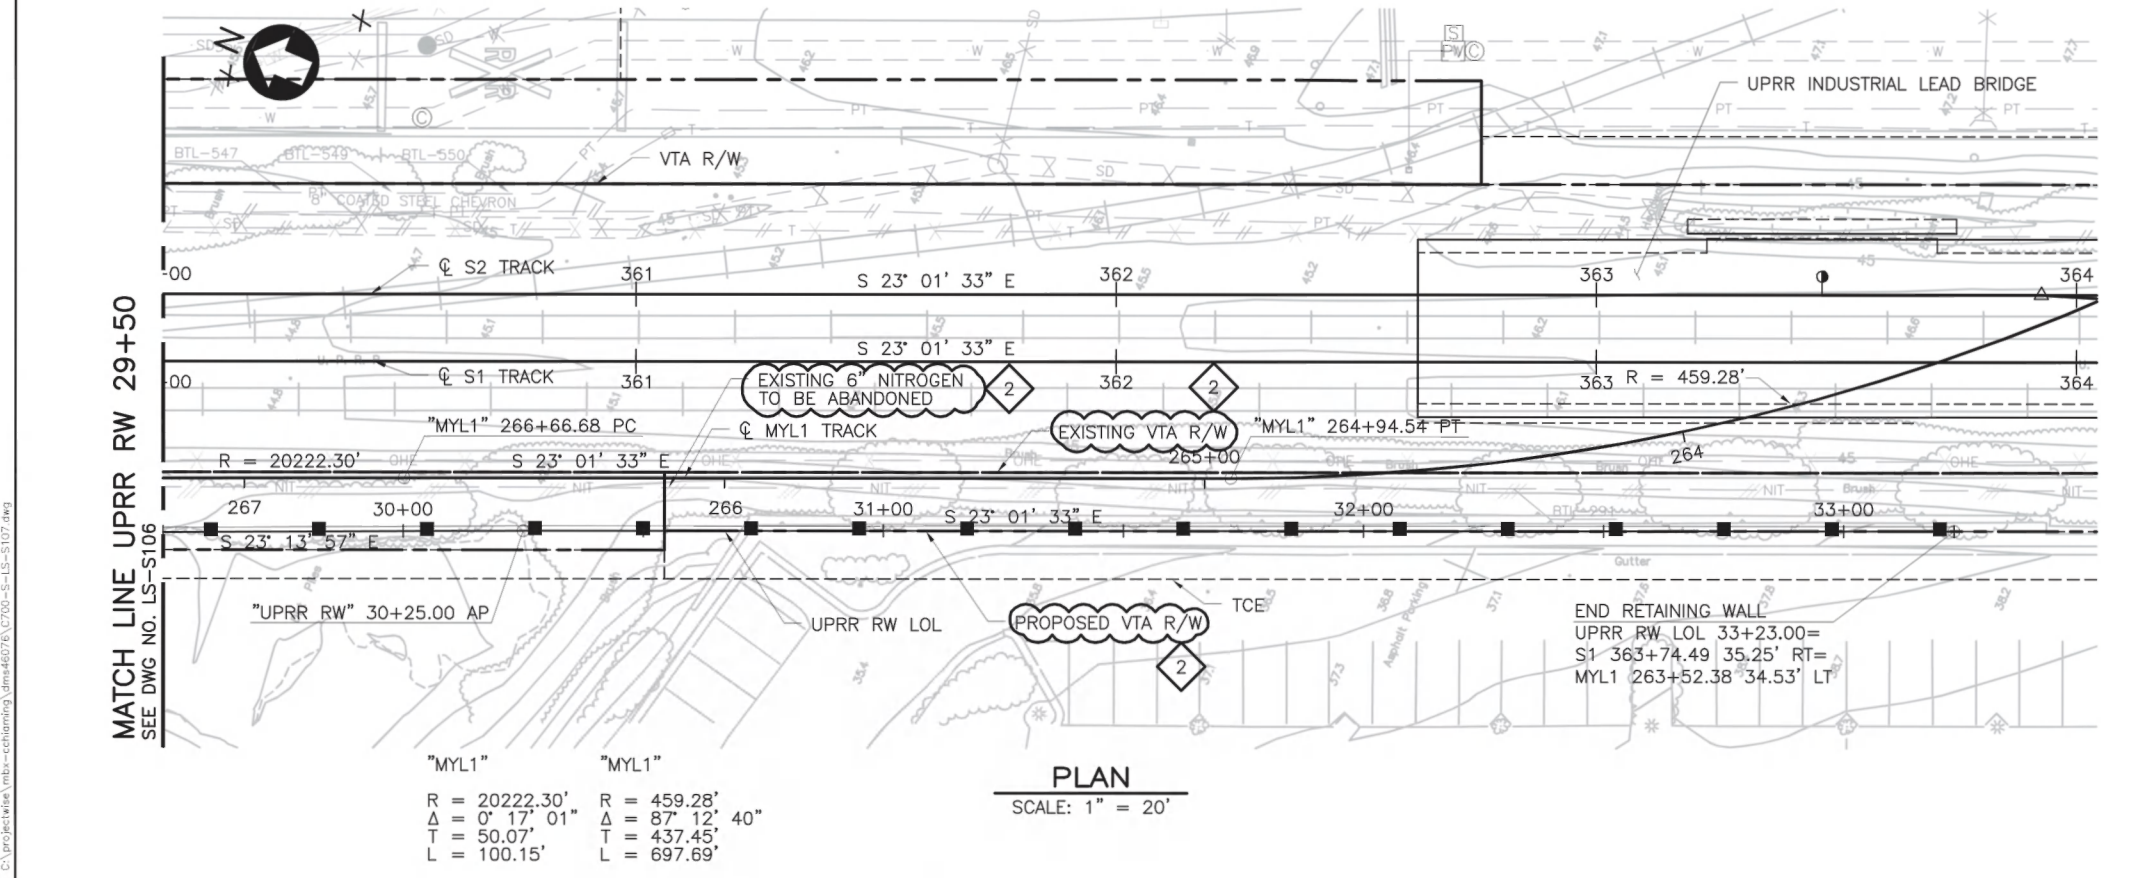

DESIGNED BY C. SONG					DRAWN BY C. CHI					CHECKED BY R. KWOK					IN CHARGE O. LI					DATE 20130416				
RFC REV 1					ADDED GROUND IMPROVEMENT					READY FOR CONSTRUCTION														
REV	DATE	BY	SUB	APP	DESCRIPTION																			
2	20130416																							
1	20130114																							
0	20121116																							

DESIGNED BY C. SONG					DRAWN BY C. CHI					CHECKED BY R. KWOK					IN CHARGE O. LI					DATE 20130416				
RFC REV 1					ADDED GROUND IMPROVEMENT					READY FOR CONSTRUCTION														
REV	DATE	BY	SUB	APP	DESCRIPTION																			
2	20130416																							
1	20130114																							
0	20121116																							

DESIGNED BY C. SONG					DRAWN BY C. CHI					CHECKED BY R. KWOK					IN CHARGE O. LI					DATE 20130416				
RFC REV 1					ADDED GROUND IMPROVEMENT					READY FOR CONSTRUCTION														
REV	DATE	BY	SUB	APP	DESCRIPTION																			


Jun 13, 2013 - 9:28am C:\projects\lms\lms-ctm\lms-ctm.dwg C:\projects\lms\lms-ctm\lms-ctm.dwg C:\projects\lms\lms-ctm\lms-ctm.dwg

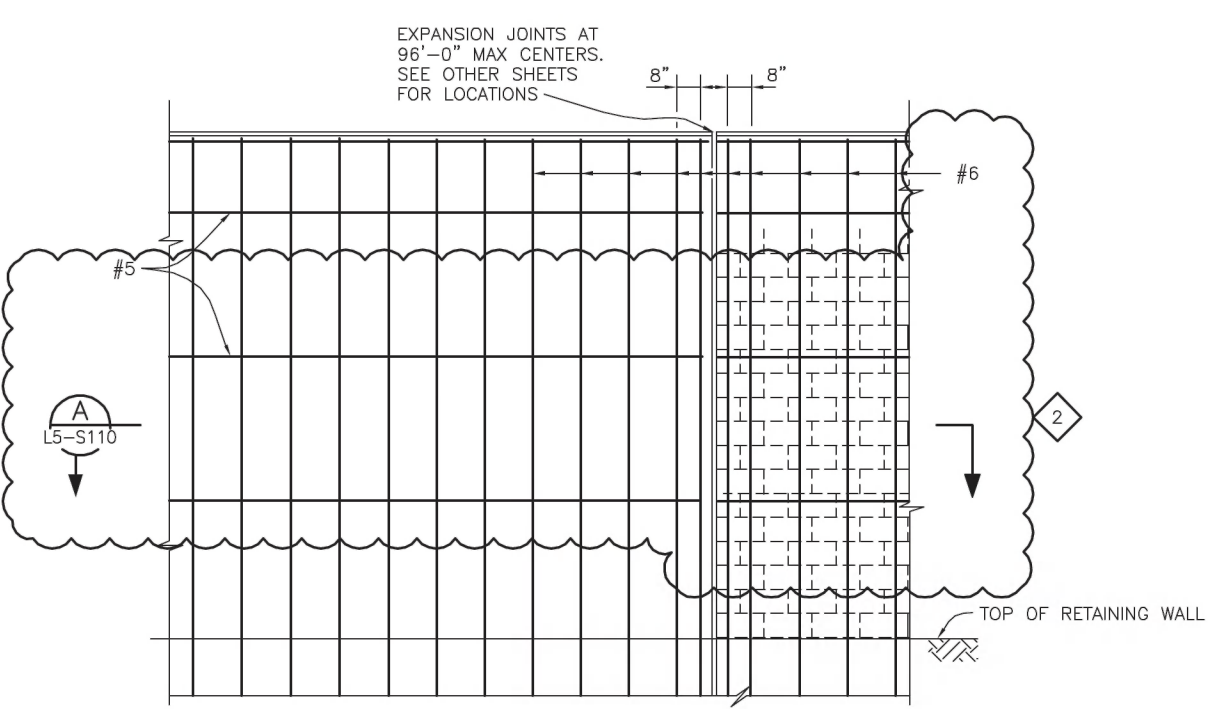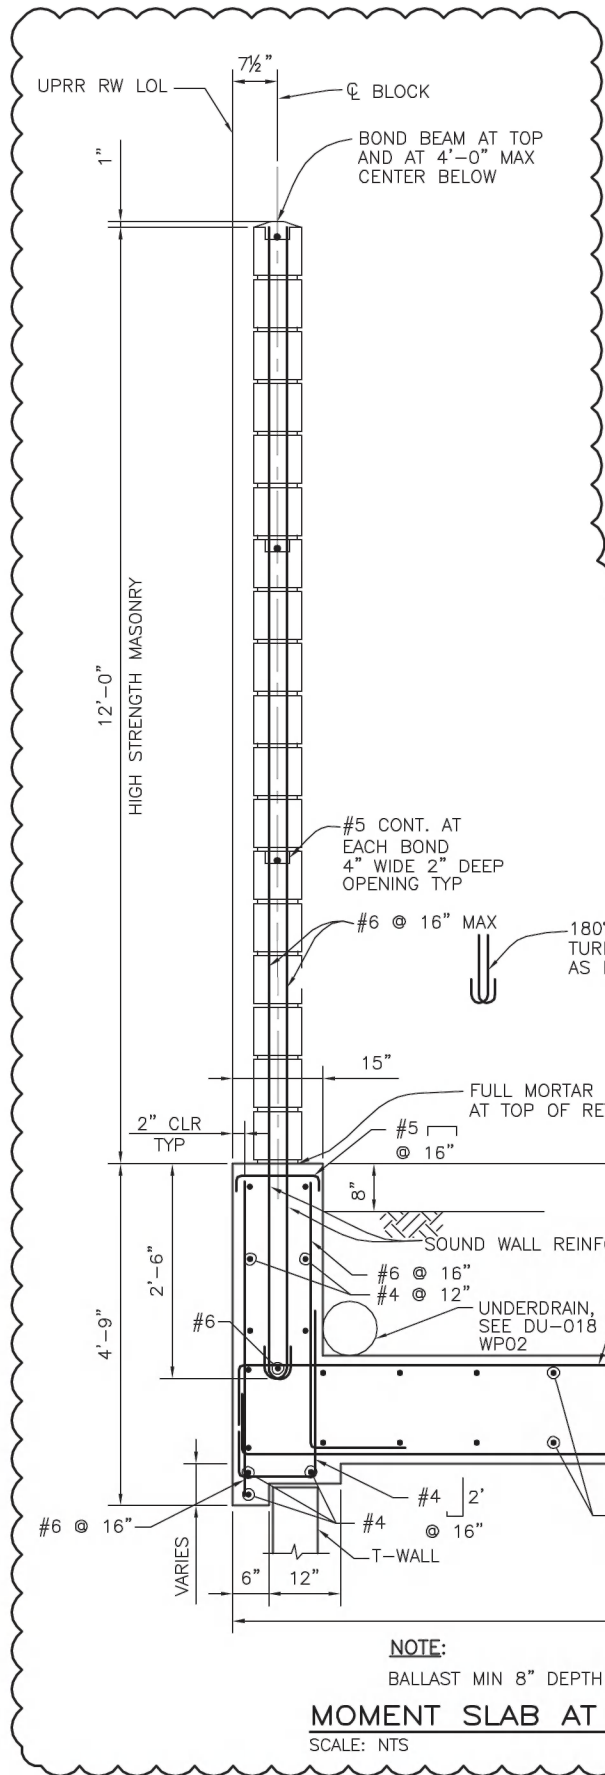

SOUND WALL ELEVATION
NTS

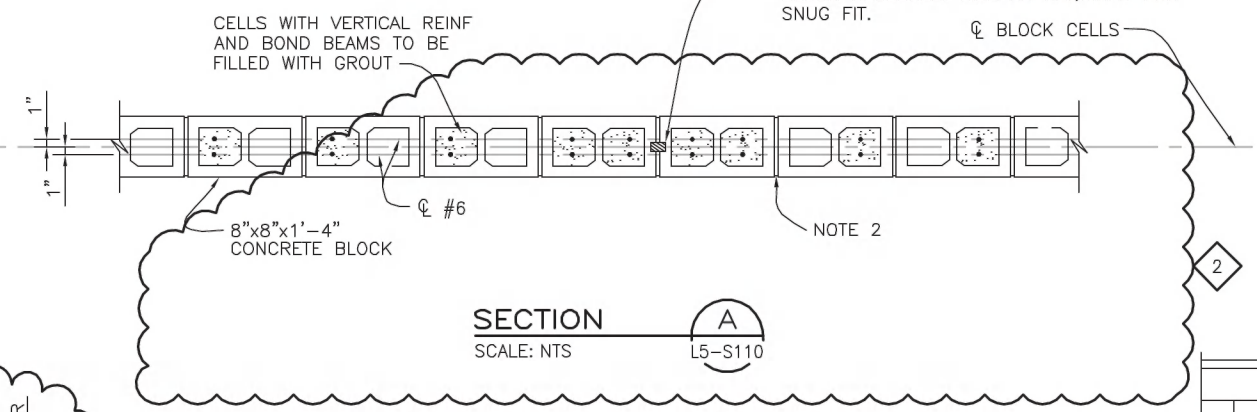

SECTION
SCALE: NTS
A
L5-S110

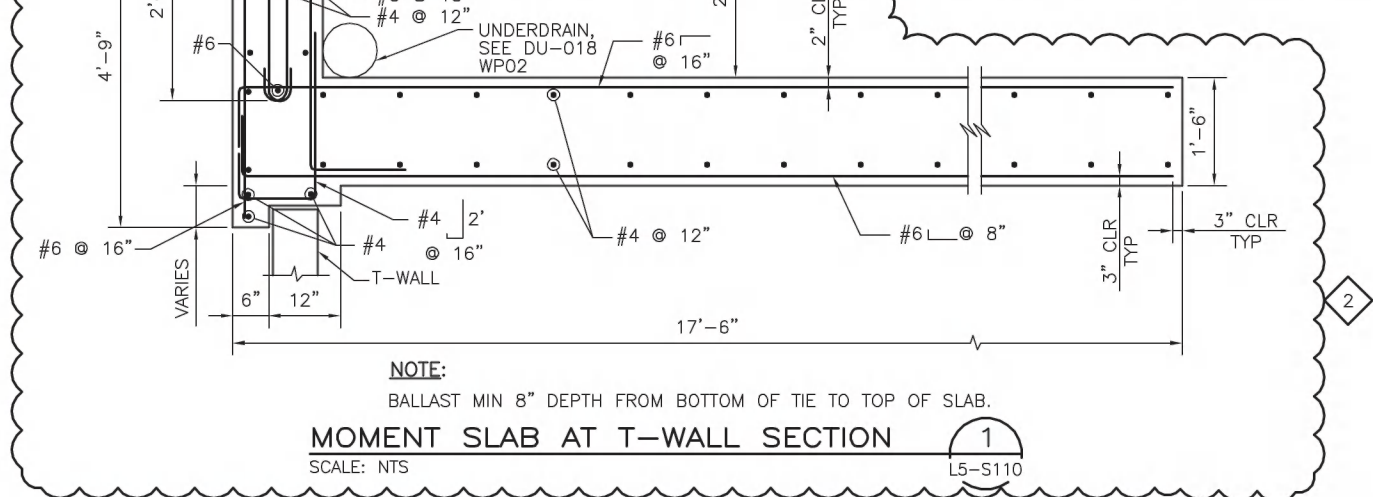

NOTE:
BALLAST MIN 8" DEPTH FROM BOTTOM OF TIE TO TOP OF SLAB.
MOMENT SLAB AT T-WALL SECTION
SCALE: NTS
1
L5-S110

NOTES:

1. WHEN BLOCKS ARE LAID IN STACKED BOND, LADDER TYPE, GALVANIZED JOINT REINFORCEMENT SHALL BE PROVIDED. A MINIMUM OF 2 - 9 GAUGE WIRES CONTINUOUS AT 4'-0" MAXIMUM TO BE USED. LOCATE REINFORCEMENT IN JOINTS THAT ARE AT THE APPROXIMATE MIDPOINT BETWEEN BOND BEAMS
2. HORIZONTAL JOINTS SHALL BE TOOLED CONCAVE OR MAY BE WEATHERED VERTICAL JOINTS SHALL BE TOOLED CONCAVE OR MAY BE RAKED
3. PER APPROVED AIP CMU SHALL BE SPLIT FACE WITH EARTH TONES - BROWN 2 COLORS, DARKER CAP MEDIUM WALL AREA, DARK BROWN GROUT, REFER TO SPECIFICATION 04 22 00 CONCRETE MASONRY

DESIGN NOTES

DESIGN

BART FACILITIES STANDARDS R2.1, AREMA 2012

DESIGN WIND LOAD


45 psf

DESIGN SEISMIC LOAD


0.53 Dead load

HIGH STRENGTH CONCRETE MASONRY

f'm = 2500 psi
f_b = 830 psi
f_s = 24,000 psi
n = 15.5

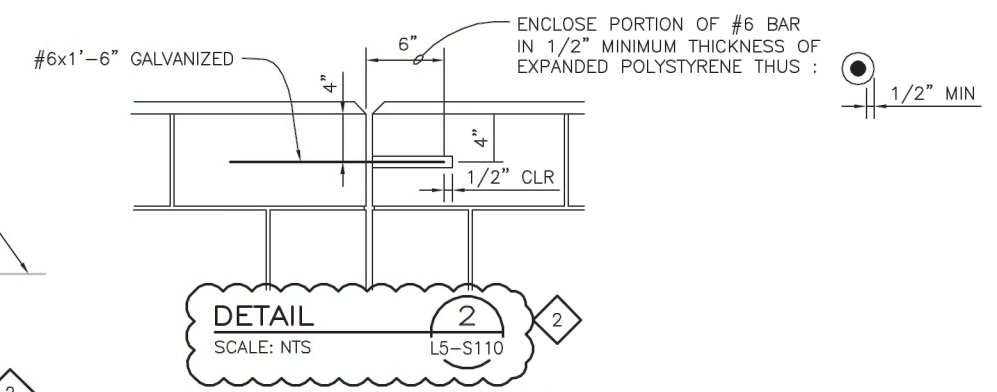

DETAIL
SCALE: NTS
2
L5-S110

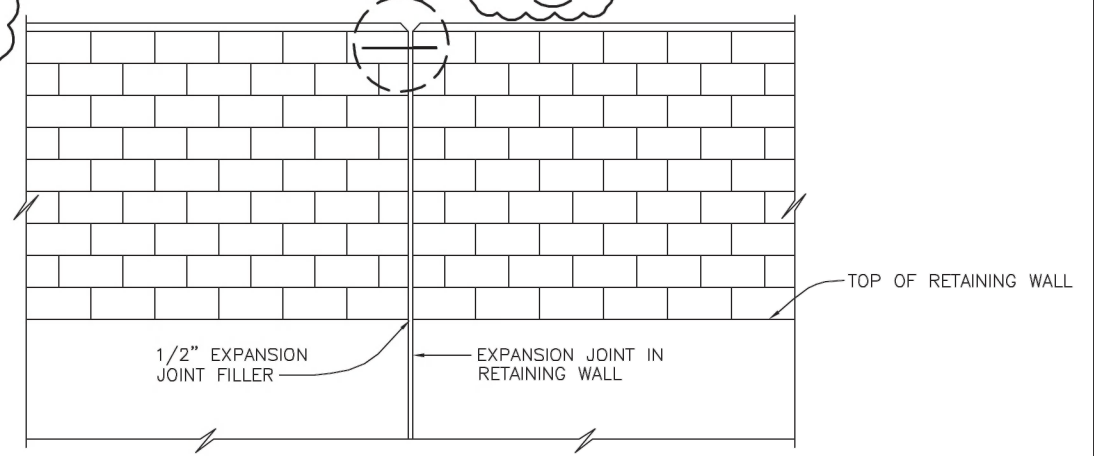

ALIGNMENT KEY DETAIL
NTS

Santa Clara Valley Transportation Authority

✓ NO EXCEPTIONS TAKEN (NET)
✓ MAKE CORRECTIONS NOTED (MCN)
✓ AMEND AND RESUBMIT (A/R)

Any action shown above is subject to the terms of the contract and does not relieve the Contractor of any of its obligations under the contract, including design and detailing.

Contract No.: DB11002F
By: [Signature] Date: 7/1/13

REV	DATE	BY	SUB	APP	DESCRIPTION
2	20130416				RFC REV 1
1	20130114				ADDED NOTE 3 FOR WALL FINISH
0	20121116				READY FOR CONSTRUCTION

DESIGNED BY
C. SONG
DRAWN BY
C. CHI
CHECKED BY
R. KWOK
IN CHARGE
O. LI
DATE
20130416



Skanska
Shimmick
Herzog

T-Y-LIN INTERNATIONAL

SUBMITTED [Signature]

1436 California Circle
Milpitas, California 95035
A Joint Venture

Lookwood, Andrews
& Newman, Inc.
A LEO A DALY COMPANY

T-Y-LIN INTERNATIONAL

APPROVED [Signature]




LINE, TRACK, STATIONS AND SYSTEMS

UPRR RETAINING WALL
SOUNDWALL DETAILS


CADD FILENAME C700-S-LS-S110.dwg	SIZE D	SCALE AS NOTED
CONTRACT NO. C700	SHEET NO. S110	REV. 2
AREA CODE LS	PAGE NO. 0015	

Jun 05, 2013 2:33pm C:\projects\l5-s-221\l5-s-221.dwg

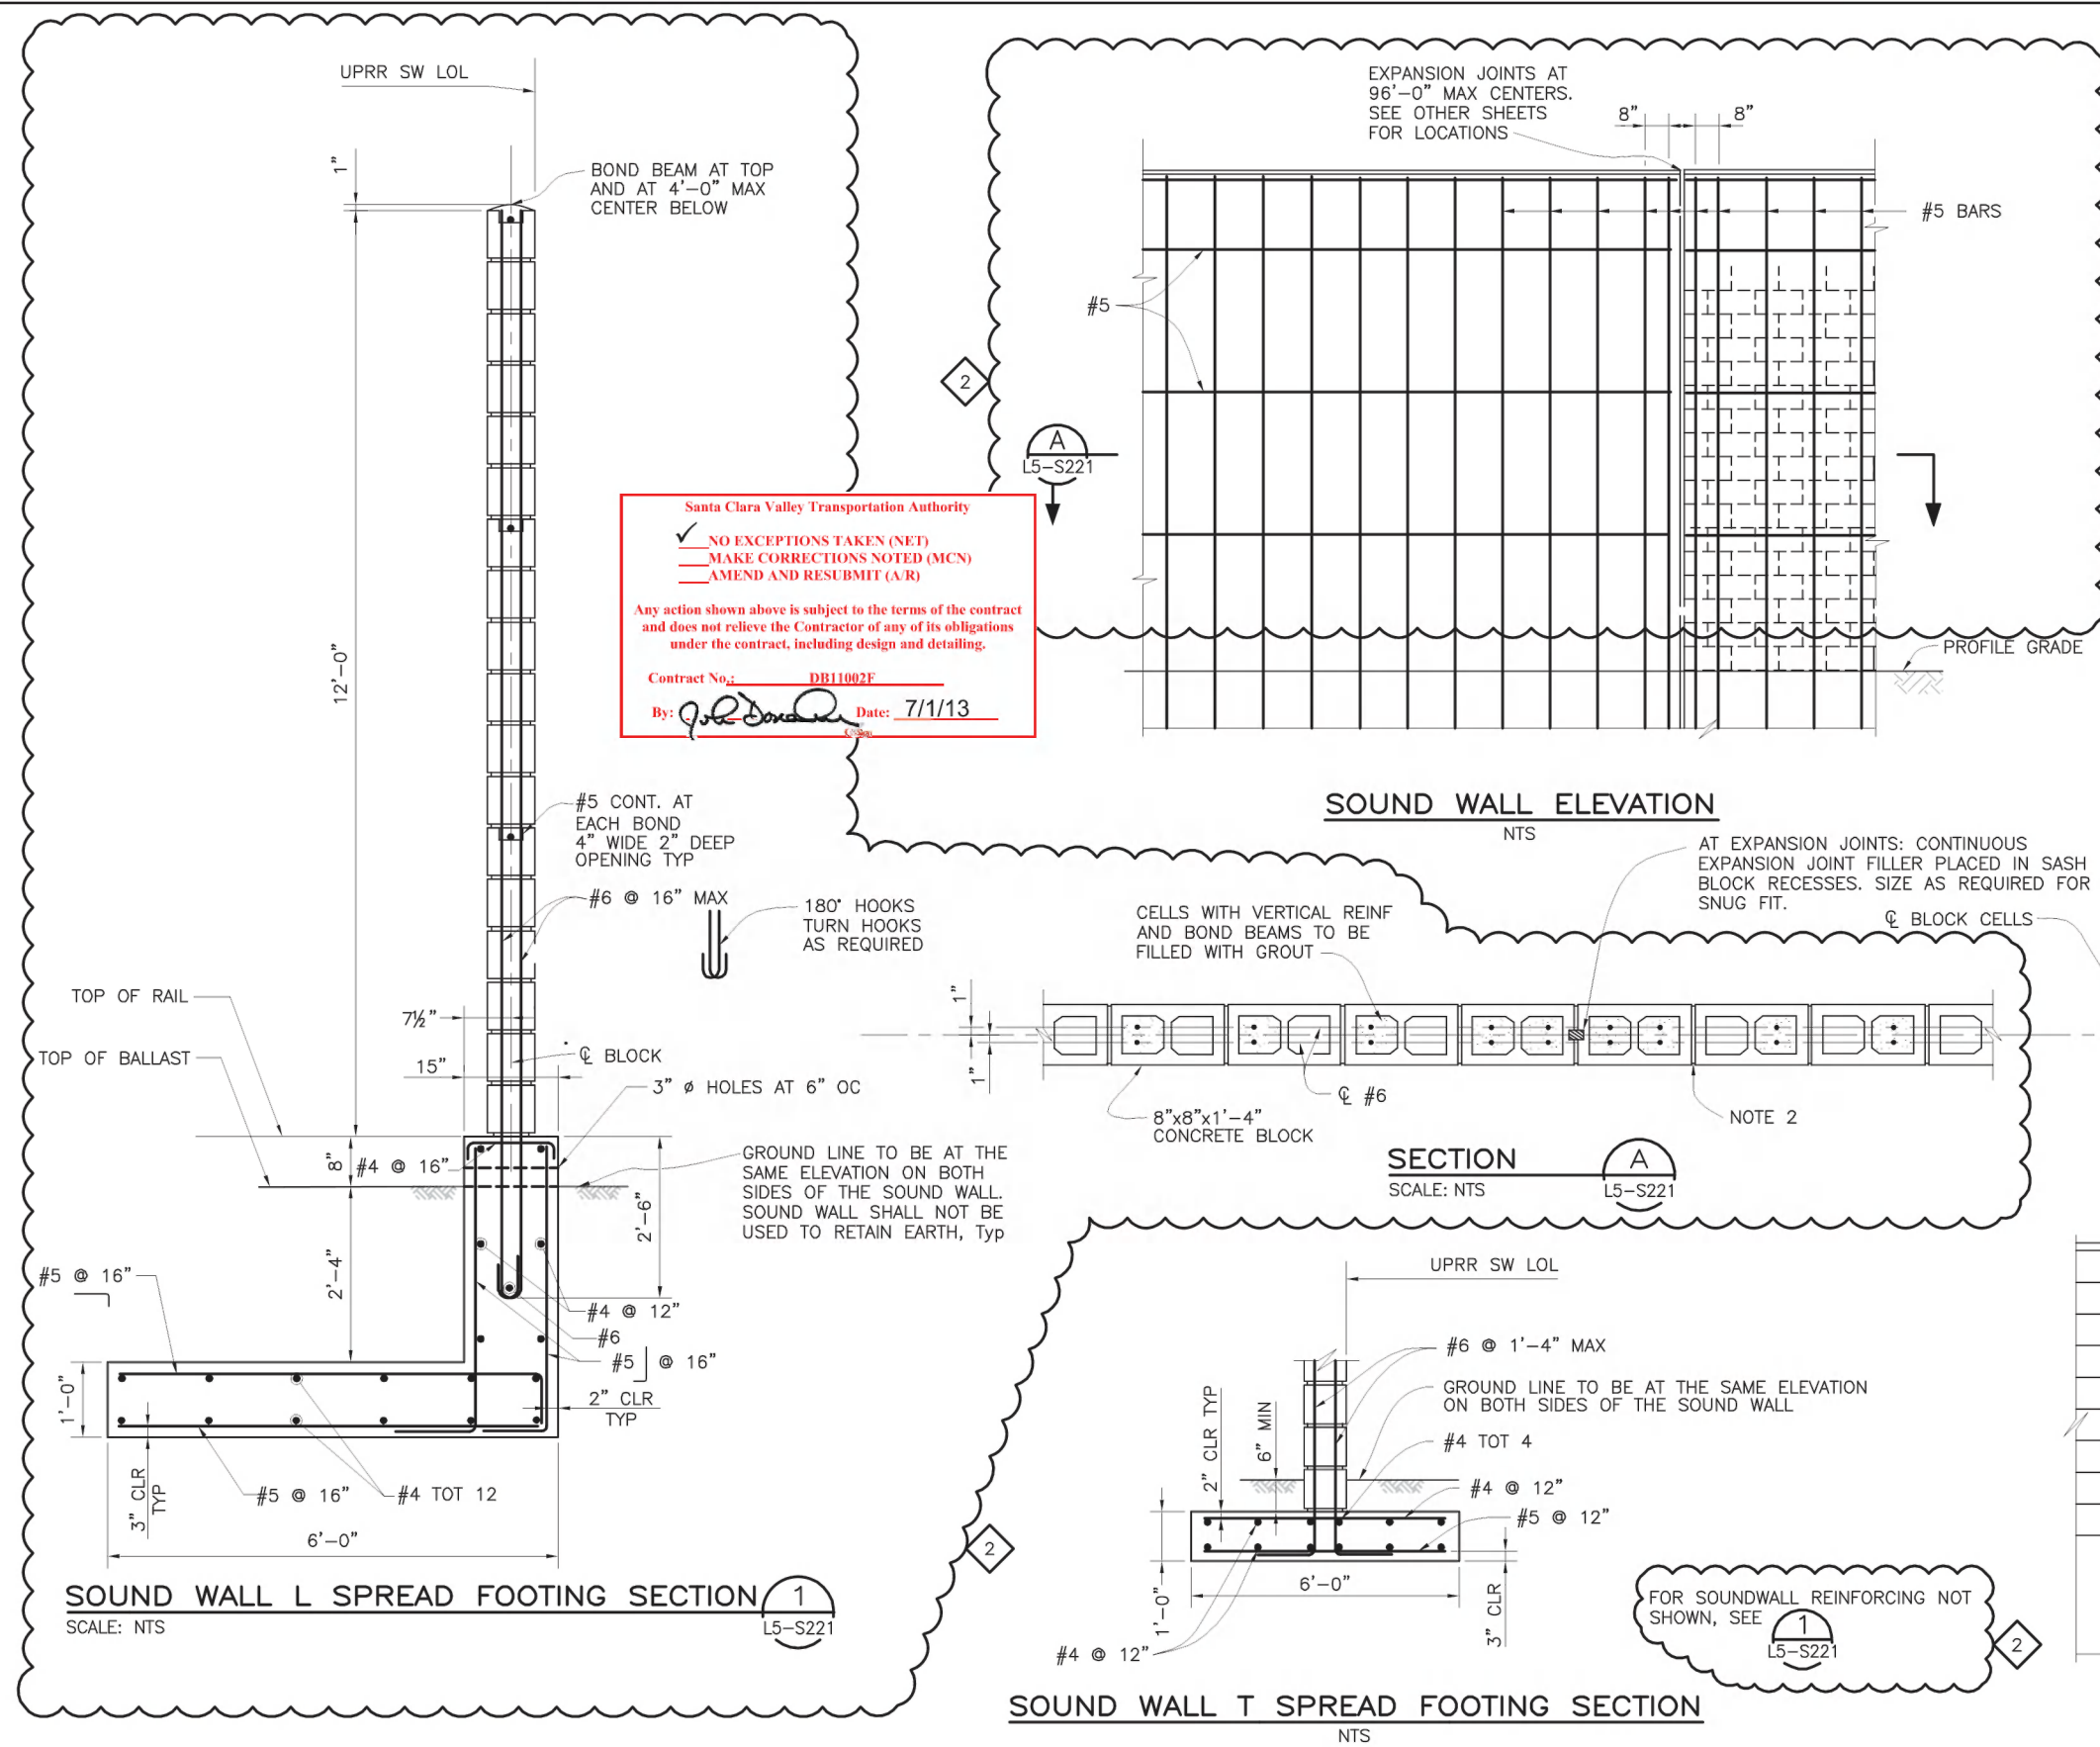

20130416				DESIGNED BY C. SONG		Skanska Shimmick Herzog	1436 California Circle Milpitas, California 95035 A Joint Venture			LINE, TRACK, STATIONS AND SYSTEMS UPRR SOUND WALL SOUND WALL DETAILS	CADD FILENAME C700-S-LS-S221.dwg		
20130416				DRAWN BY C. CHI							SIZE D	AS NOTED	
20130114				CHECKED BY R. KWOK							CONTRACT NO.	C700	REV. 2
20121116				IN CHARGE O. LI							AREA CODE	LS	PAGE NO. 0017
REV	DATE	BY	SUB	APP	DESCRIPTION	DATE	20130416	DATE	20130416	DATE	20130416	DATE	20130416

Nov 16, 2012 10:03am S:\ACAD\2011-12-SN SYBK VIA LOTBA\Structures\UPRR Industrial Lead Bridge and Walls\UPRR RW&SW\C700-S-L5-S285A.dwg

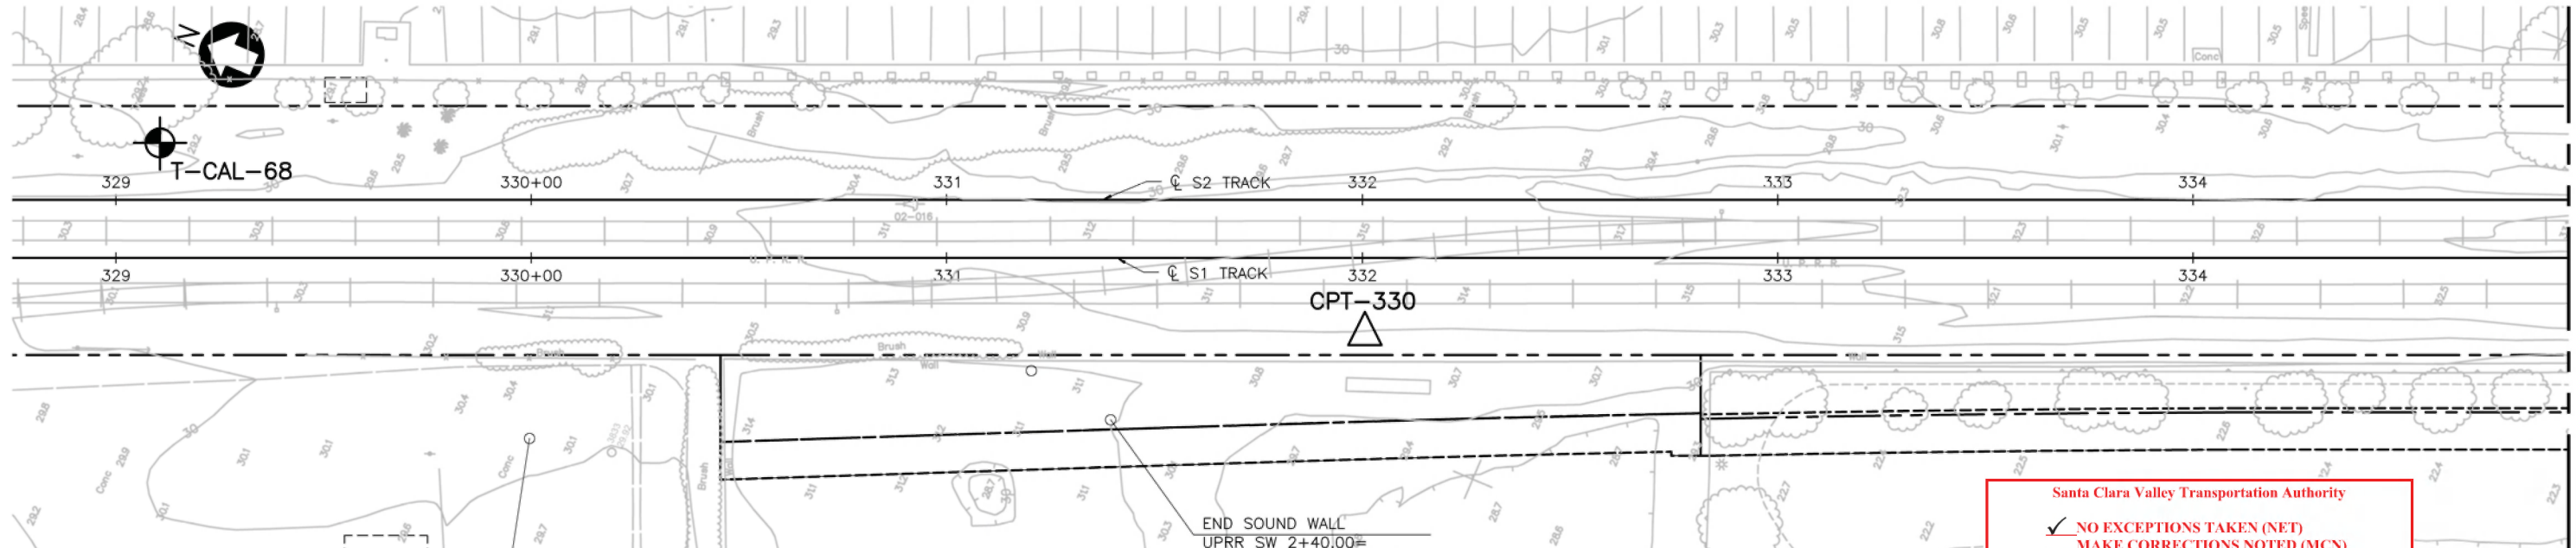

BEGIN SOUND WALL
UPRR SW LOL 1+00.00=
S1 329+99.61 43.51' RT=
MYL1 297+19.27 10.83' LT


END SOUND WALL
UPRR SW 2+40.00=
S1 331+39.54 39.02' RT=
MYL1 295+79.27 10.83' LT=
UPRR RW 0+88.00

Santa Clara Valley Transportation Authority

✓ NO EXCEPTIONS TAKEN (NET)
MAKE CORRECTIONS NOTED (MCN)
AMEND AND RESUBMIT (A/R)

Any action shown above is subject to the terms of the contract and does not relieve the Contractor of any of its obligations under the contract, including design and detailing.

Contract No.: DB11002F
By: *[Signature]* Date: 7/1/13

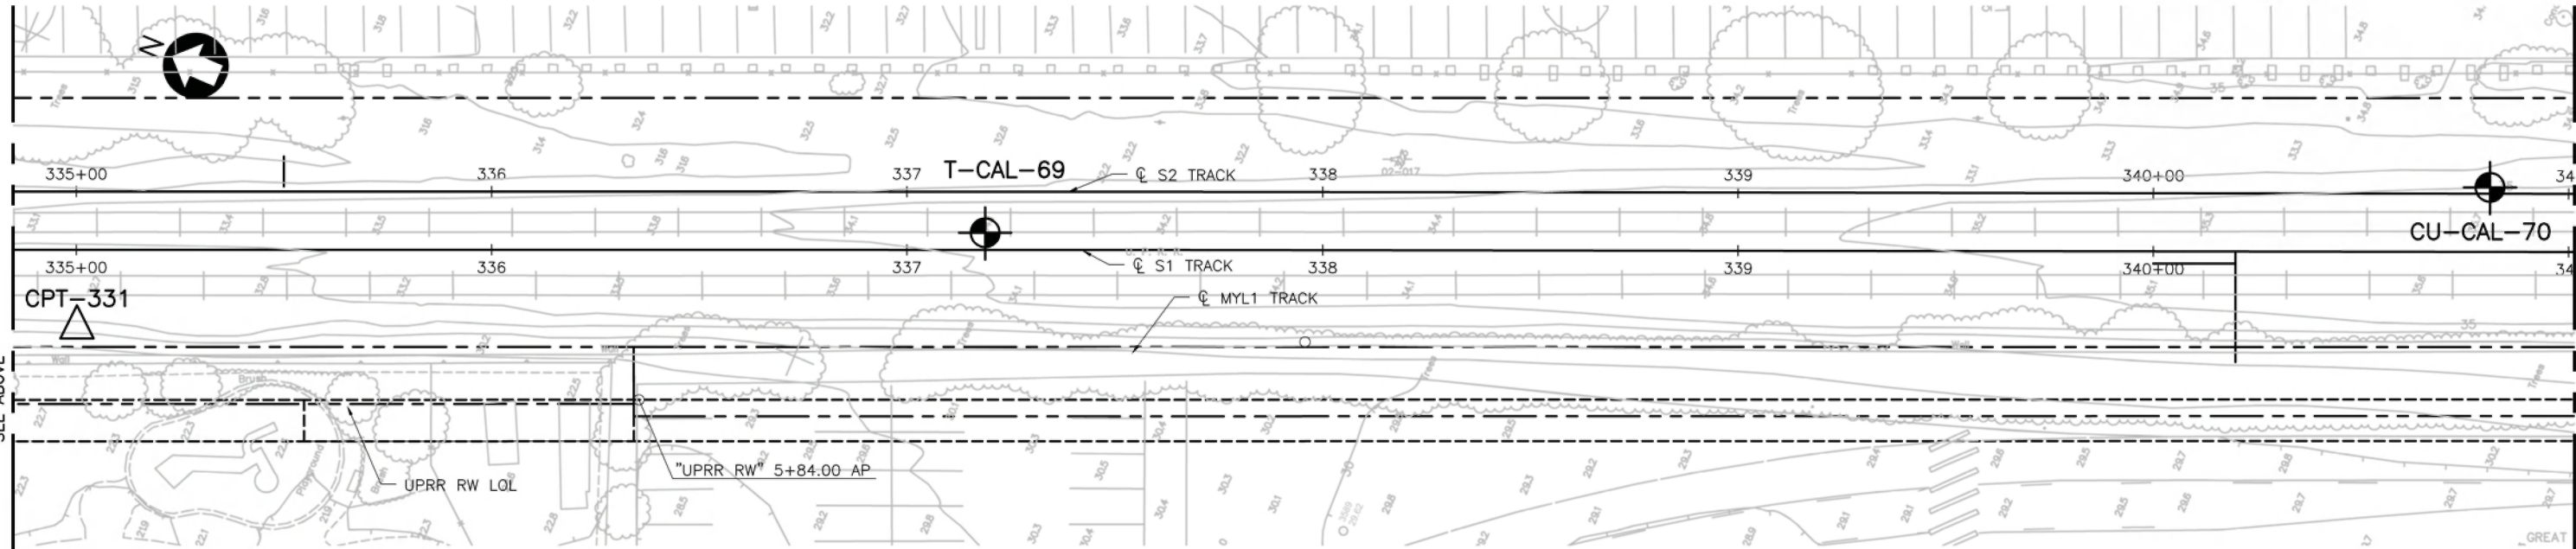

LEGEND:

- △ CPT (PERFORMED UNDER C700)
- ⊕ REFERENCE BORINGS (FROM RFP)
- ▲ REFERENCE CPT (FROM RFP)


PLAN



GRAPHIC SCALE

REV	DATE	BY	SUB	APP	DESCRIPTION
0	20121102				READY FOR CONSTRUCTION

DESIGNED BY
O. GOUTHIER
DRAWN BY
O. GOUTHIER
CHECKED BY
F. WANG
IN CHARGE
G. PARIKH
DATE
20121102

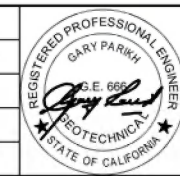

Skanska
Shimmick
Herzog

PARIKH CONSULTANTS, INC.
2800 QUINN DRIVE, SUITE A
SAN JOSE, CA 95131

1436 California Circle
Milpitas, California 95035
A Joint Venture

Lockwood, Andrews
& Newnam, Inc.
A LEAD & DAILY COMPANY

T-Y-LIN INTERNATIONAL




LINE, TRACK, STATIONS AND SYSTEMS

UPRR RETAINING WALLS/SOUND WALLS
LOG OF TEST BORINGS 1 OF 6

CADD FILENAME C700-S-L5-S285A.dwg	SIZE D	SCALE AS NOTED
CONTRACT NO. C700	REVISION 0	PAGE NO. 0018
AREA CODE L5	SHEET NO. S285A	

Nov 15, 2012 9:35am S:\ACAD\2011-120-SVN SVB\VTA\OTBs\Structures\UPRR Industrial Lead Bridge and Walls\UPRR Plan\DWG\700-S-L5-S286A.dwg

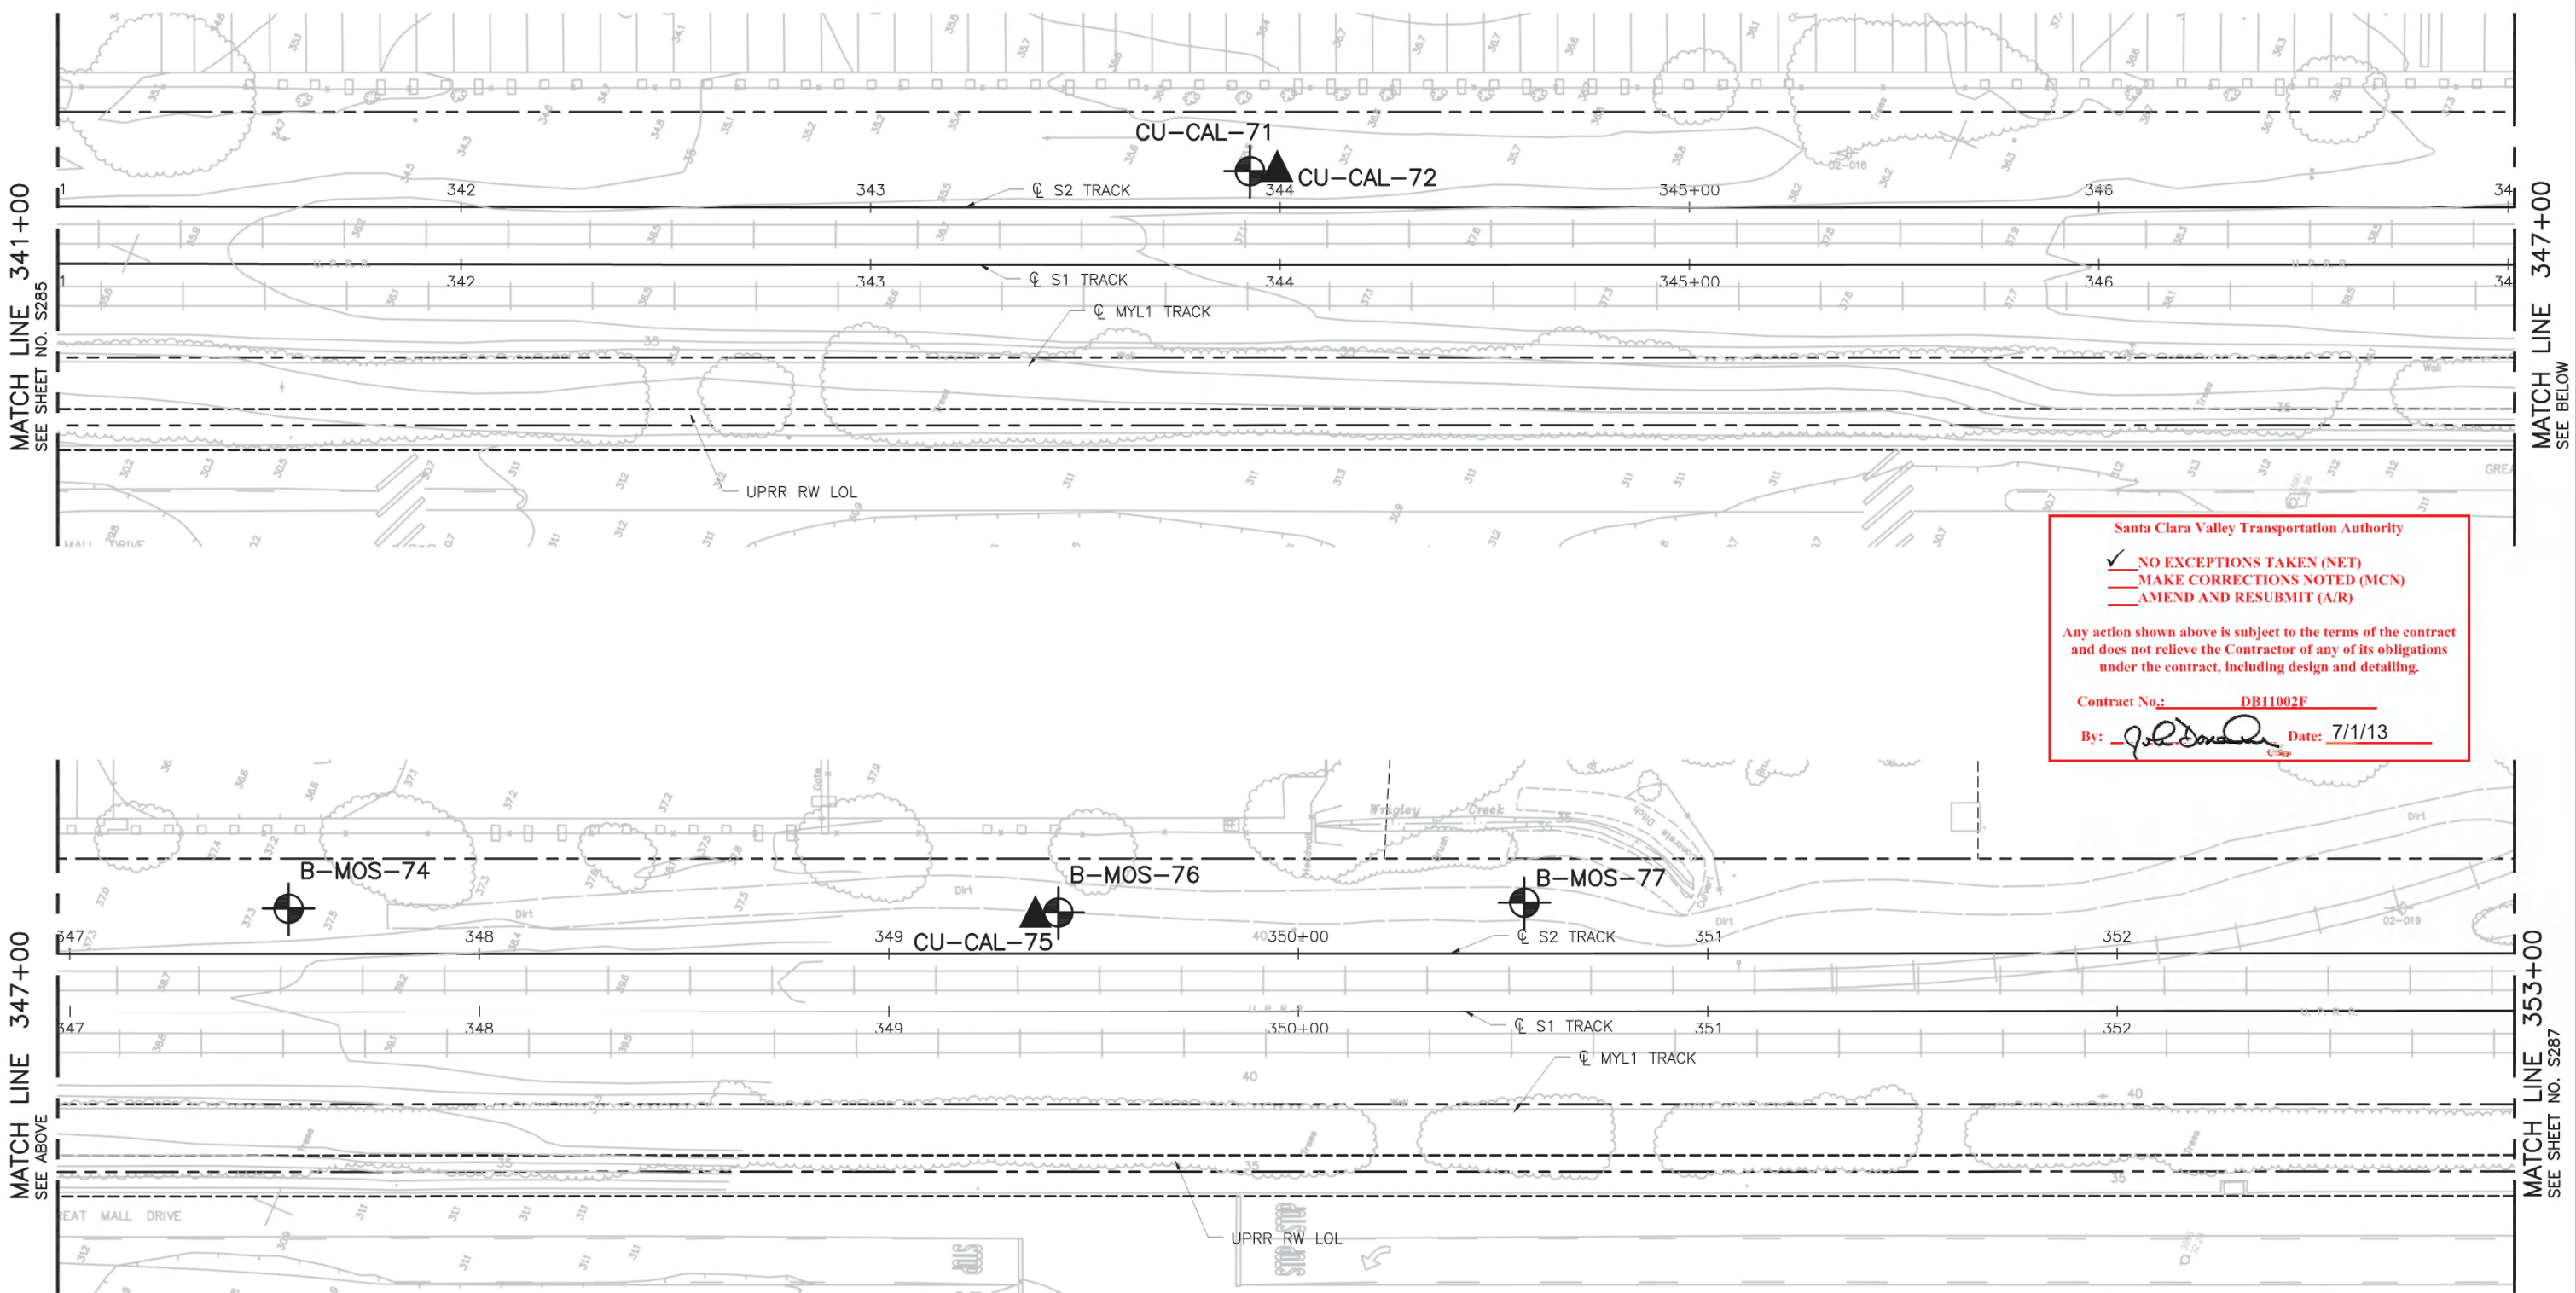

Santa Clara Valley Transportation Authority

☒ NO EXCEPTIONS TAKEN (NET)
☐ MAKE CORRECTIONS NOTED (MCN)
☐ AMEND AND RESUBMIT (A/R)

Any action shown above is subject to the terms of the contract and does not relieve the Contractor of any of its obligations under the contract, including design and detailing.

Contract No.: DB11002F

By: [Signature] Date: 7/1/13

LEGEND:

- △ CPT (PERFORMED UNDER C700)
- ⊕ REFERENCE BORINGS (FROM RFP)
- ▲ REFERENCE CPT (FROM RFP)


PLAN



GRAPHIC SCALE

REV	DATE	BY	SUB	APP	DESCRIPTION
0	20121102				READY FOR CONSTRUCTION

DESIGNED BY
O. GOUTHIER
DRAWN BY
O. GOUTHIER
CHECKED BY
F. WANG
IN CHARGE
G. PARIKH
DATE
20121102

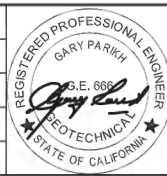

Skanska
Shimmick
Herzog

1436 California Circle
Milpitas, California 95035
A Joint Venture

PARIKH CONSULTANTS, INC.
2880 QUINN DRIVE, SUITE A
SAN JOSE, CA 95131

Lockwood, Andrews
& Newnam, Inc.
A LEO A DALY COMPANY

T-Y LIN INTERNATIONAL

BART
SILICON VALLEY

BART SILICON VALLEY BERRYESSA EXTENSION

LINE, TRACK, STATIONS AND SYSTEMS

UPRR RETAINING WALLS/SOUND WALLS
LOG OF TEST BORINGS 2 OF 6

CADD FILENAME C700-S-L5-S286A.dwg	REV. 0
SIZE SCALE D AS NOTED	REV. 0
CONTRACT NO. C700	REV. 0
AREA CODE L5	SHEET NO. S286A
PAGE NO. 0019	

Nov 15, 2012 - 9:57am S:\ACAD\2011-120-SVN (SIV) (TAL\OTB)\Structures\UPRR Industrial Lead Bridge and Walls\UPRR PW287A\700-S-LS-S287A.dwg
Gouthier

MATCH LINE 353+00
SEE SHEET NO. S286

MATCH LINE 359+00
SEE ABOVE

MATCH LINE 359+00
SEE BELOW

Santa Clara Valley Transportation Authority


☒ NO EXCEPTIONS TAKEN (NET)
☐ MAKE CORRECTIONS NOTED (MCN)
☐ AMEND AND RESUBMIT (A/R)

Any action shown above is subject to the terms of the contract and does not relieve the Contractor of any of its obligations under the contract, including design and detailing.

Contract No.: DB11002F

By: [Signature] Date: 7/1/13

- LEGEND:
-  CPT (PERFORMED UNDER C700)
 -  REFERENCE BORINGS (FROM RFP)
 -  REFERENCE CPT (FROM RFP)

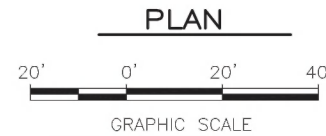

REV	DATE	BY	SUB	APP	DESCRIPTION
0	20121102				READY FOR CONSTRUCTION

DESIGNED BY
O. GOUTHIER
DRAWN BY
O. GOUTHIER
CHECKED BY
F. WANG
IN CHARGE
G. PARIKH
DATE
20121102



Skanska
Shimmick
Herzog

1436 California Circle
Milpitas, California 95035
A Joint Venture

PARIKH CONSULTANTS, INC.
2385 OLIVE DRIVE, SUITE A
SAN JOSE, CA 95131

Lookwood, Andrews
& Newnam, Inc.
A LEQ A BALLY COMPANY

T-Y LIN INTERNATIONAL

BART
SILICON VALLEY

BART SILICON VALLEY BERRYESSA EXTENSION

LINE, TRACK, STATIONS AND SYSTEMS

UPRR RETAINING WALLS/SOUND WALLS
LOG OF TEST BORINGS 3 OF 6

CADD FILENAME C700-S-LS-S287A.dwg	REV. 0
SIZE D	SCALE AS NOTED
CONTRACT NO. C700	PAGE NO. 0020
AREA CODE L5	SHEET NO. S287A

Santa Clara Valley Transportation Authority

☒ **NO EXCEPTIONS TAKEN (NET)**
☐ **MAKE CORRECTIONS NOTED (MCN)**
☐ **AMEND AND RESUBMIT (A/R)**


Any action shown above is subject to the terms of the contract and does not relieve the Contractor of any of its obligations under the contract, including design and detailing.

Contract No.: DB11002F

By:  Date: 7/1/13

Contract

CONSISTENCY OF COHESIVE SOILS				
Description	Shear Strength (tsf)	Pocket Penetrometer Measurement, PP, (tsf)	Torvane Measurement, TV, (tsf)	Vane Shear Measurement, VS, (tsf)
Very Soft	Less than 0.12	Less than 0.25	Less than 0.12	Less than 0.12
Soft	0.12 – 0.25	0.25 – 0.5	0.12 – 0.25	0.12 – 0.25
Medium Stiff	0.25 – 0.5	0.5 – 1	0.25 – 0.5	0.25 – 0.5
Stiff	0.5 – 1	1 – 2	0.5 – 1	0.5 – 1
Very Stiff	1 – 2	2 – 4	1 – 2	1 – 2
Hard	Greater than 2	Greater than 4	Greater than 2	Greater than 2

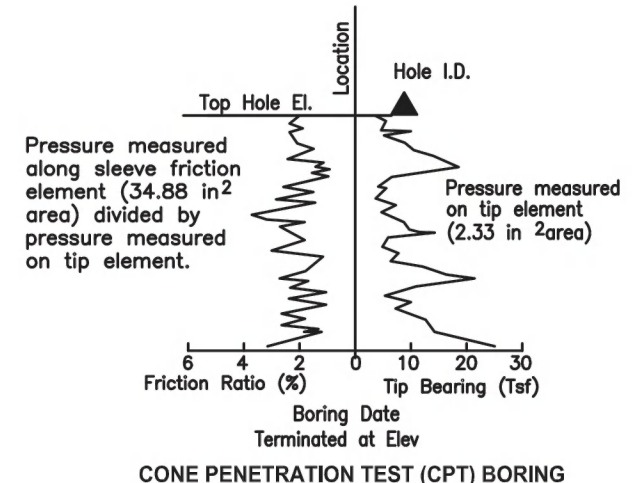

REFERENCE: CALTRANS SOIL & ROCK LOGGING, CLASSIFICATION, AND PRESENTATION MANUAL (2010)

GROUP SYMBOLS AND NAMES			
Graphic/Symbol	Group Names		Graphic/Symbol
	GW	Well-graded GRAVEL Well-graded GRAVEL with SAND	
	GP	Poorly-graded GRAVEL Poorly-graded GRAVEL with SAND	
	GW-GM	Well-graded GRAVEL with SILT Well-graded GRAVEL with SILT and SAND	
	GW-GC	Well-graded GRAVEL with CLAY (or SILTY CLAY) Well-graded GRAVEL with CLAY and SAND (or SILTY CLAY and SAND)	
	GP-GM	Poorly-graded GRAVEL with SILT Poorly-graded GRAVEL with SILT and SAND	
	GP-GC	Poorly-graded GRAVEL with CLAY (or SILTY CLAY) Poorly-graded GRAVEL with CLAY and SAND (or SILTY CLAY and SAND)	
	GM	SILTY GRAVEL SILTY GRAVEL with SAND	
	GC	CLAYEY GRAVEL CLAYEY GRAVEL with SAND	
	GC-GM	SILTY, CLAYEY GRAVEL SILTY, CLAYEY GRAVEL with SAND	
	SW	Well-graded SAND Well-graded SAND with GRAVEL	
	SP	Poorly-graded SAND Poorly-graded SAND with GRAVEL	
	SW-SM	Well-graded SAND with SILT Well-graded SAND with SILT and GRAVEL	
	SW-SC	Well-graded SAND with CLAY (or SILTY CLAY) Well-graded SAND with CLAY and GRAVEL (or SILTY CLAY and GRAVEL)	
	SP-SM	Poorly-graded SAND with SILT Poorly-graded SAND with SILT and GRAVEL	
	SP-SC	Poorly-graded SAND with CLAY (or SILTY CLAY) Poorly-graded SAND with CLAY and GRAVEL (or SILTY CLAY and GRAVEL)	
	SM	SILTY SAND SILTY SAND with GRAVEL	
	SC	CLAYEY SAND CLAYEY SAND with GRAVEL	
	SC-SM	SILTY, CLAYEY SAND SILTY, CLAYEY SAND with GRAVEL	
	PT	PEAT	
		COBBLES COBBLES and BOULDERS BOULDERS	

FIELD AND LABORATORY TESTING	
	Consolidation (ASTM D 2435)
	Collapse Potential (ASTM D 5333)
	Compaction Curve (CTM 216)
	Corrosivity Testing (CTM 643, CTM 422, CTM 417)
	Consolidated Undrained Triaxial (ASTM D 4767)
	Direct Shear (ASTM D 3080)
	Expansion Index (ASTM D 4829)
	Moisture Content (ASTM D 2216)
	Organic Content-% (ASTM D 2974)
	Permeability (CTM 220)
	Particle Size Analysis (ASTM D 422)
	Plasticity Index (AASHTO T 90) Liquid Limit (AASHTO T 89)
	Point Load Index (ASTM D 5731)
	Pressure Meter
	R-Value (CTM 301)
	Sand Equivalent (CTM 217)
	Specific Gravity (AASHTO T 100)
	Shrinkage Limit (ASTM D 427)
	Swell Potential (ASTM D 4546)
	Unconfined Compression--Soil (ASTM D 2166) Unconfined Compression--Rock (ASTM D 2938)
	Unconsolidated Undrained Triaxial (ASTM D 2850)
	Unit Weight (ASTM D 4767)

Santa Clara Valley Transportation Authority

☒ NO EXCEPTIONS TAKEN (NET)
☐ MAKE CORRECTIONS NOTED (MCN)
☐ AMEND AND RESUBMIT (A/R)

Any action shown above is subject to the terms of the contract and does not relieve the Contractor of any of its obligations under the contract, including design and detailing.

Contract No.: DB11002F

By: Date: 7/1/13

APPARENT DENSITY OF COHESIONLESS SOILS	
Description	SPT N ₆₀ (Blows / 12 in.)
Very Loose	0 – 5
Loose	5 – 10
Medium Dense	10 – 30
Dense	30 – 50
Very Dense	Greater than 50


MOISTURE	
Description	Criteria
Dry	No discernable moisture
Moist	Moisture present, but no free water
Wet	Visible free water

PERCENT OR PROPORTION OF SOILS	
Description	Criteria
Trace	Particles are present but estimated to be less than 5%
Few	5% – 10%
Little	15% – 25%
Some	30% – 45%
Mostly	50% – 100%

PARTICLE SIZE		
Description		Size (in.)
Boulder		Greater than 12
Cobble		3 – 12
Gravel	Coarse	3/4 – 3
	Fine	1/5 – 3/4
Sand	Coarse	1/16 – 1/5
	Medium	1/64 – 1/16
	Fine	1/300 – 1/64
Silt and Clay		Less than 1/300

Nov 15, 2012 9:38am S:\A240\2011-120-SVN S\B\ VTA\UTBs\Structures\UPRR Industrial Lead Bridge and Walls\UPPR File\DWG\CT00-S-L5-S289A.dwg

Nov 16, 2012						DESIGNED BY O. GOUHIER
						DRAWN BY O. GOUHIER
						CHECKED BY F. WANG
						IN CHARGE G. PARIKH
Gouhier	0	20121102			READY FOR CONSTRUCTION	DATE 20121102
	REV	DATE	BY	SUB	APP	DESCRIPTION

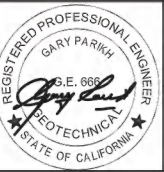

Skanska
Shimmick
Herzog

1436 California Circle
Milpitas, California 95035
A Joint Venture

PARIKH CONSULTANTS, INC.
2880 OLIVE DRIVE, SUITE A
SAN JOSE, CA 95131

LOCKWOOD, ANDREWS
& NEWNAM, INC.
A LEI A DAILY COMPANY

T-Y LIN INTERNATIONAL

APPROVED

BART
SILICON VALLEY

BART SILICON VALLEY BERRYESSA EXTENSION

LINE, TRACK, STATIONS AND SYSTEMS			
UPRR RETAINING WALLS/SOUND WALLS LOG OF TEST BORINGS 5 OF 6			
CADD FILENAME C700-S-L5-S289A.dwg	SIZE SCALE D AS NOTED	CONTRACT NO. C700	REV. 0
AREA CODE L5	SHEET NO. S289A	PAGE NO. 0022	

Nov 15, 2012 9:39am S:\ACAD\2011-120-SVN-SVBK\UTB\Structures\UPRR Retaining Walls\UPRR Retaining Walls\UTB-S290A.dwg

SEE SHEET 1 OF 6 FOR BORING LOCATIONS

NOTES:

1. STANDARD PENETRATION TEST SAMPLER: I.D. = 1.4"; O.D. = 2"
MODIFIED CALIFORNIA SAMPLER: I.D. = 2.5"; O.D. = 3"
SHELBY TUBE SAMPLER: I.D. = 2.875", O.D. = 30"
HAMMER ASSEMBLY: A 140 LB HAMMER WITH A 30" DROP (AUTOMATIC HAMMER)
2. ALL DIMENSIONS ARE IN FEET UNLESS OTHERWISE SHOWN

Santa Clara Valley Transportation Authority

☒ NO EXCEPTIONS TAKEN (NET)


☐ MAKE CORRECTIONS NOTED (MCN)


☐ AMEND AND RESUBMIT (A/R)

Any action shown above is subject to the terms of the contract and does not relieve the Contractor of any of its obligations under the contract, including design and detailing.

Contract No.: DB11002F

By:  Date: 7/1/13

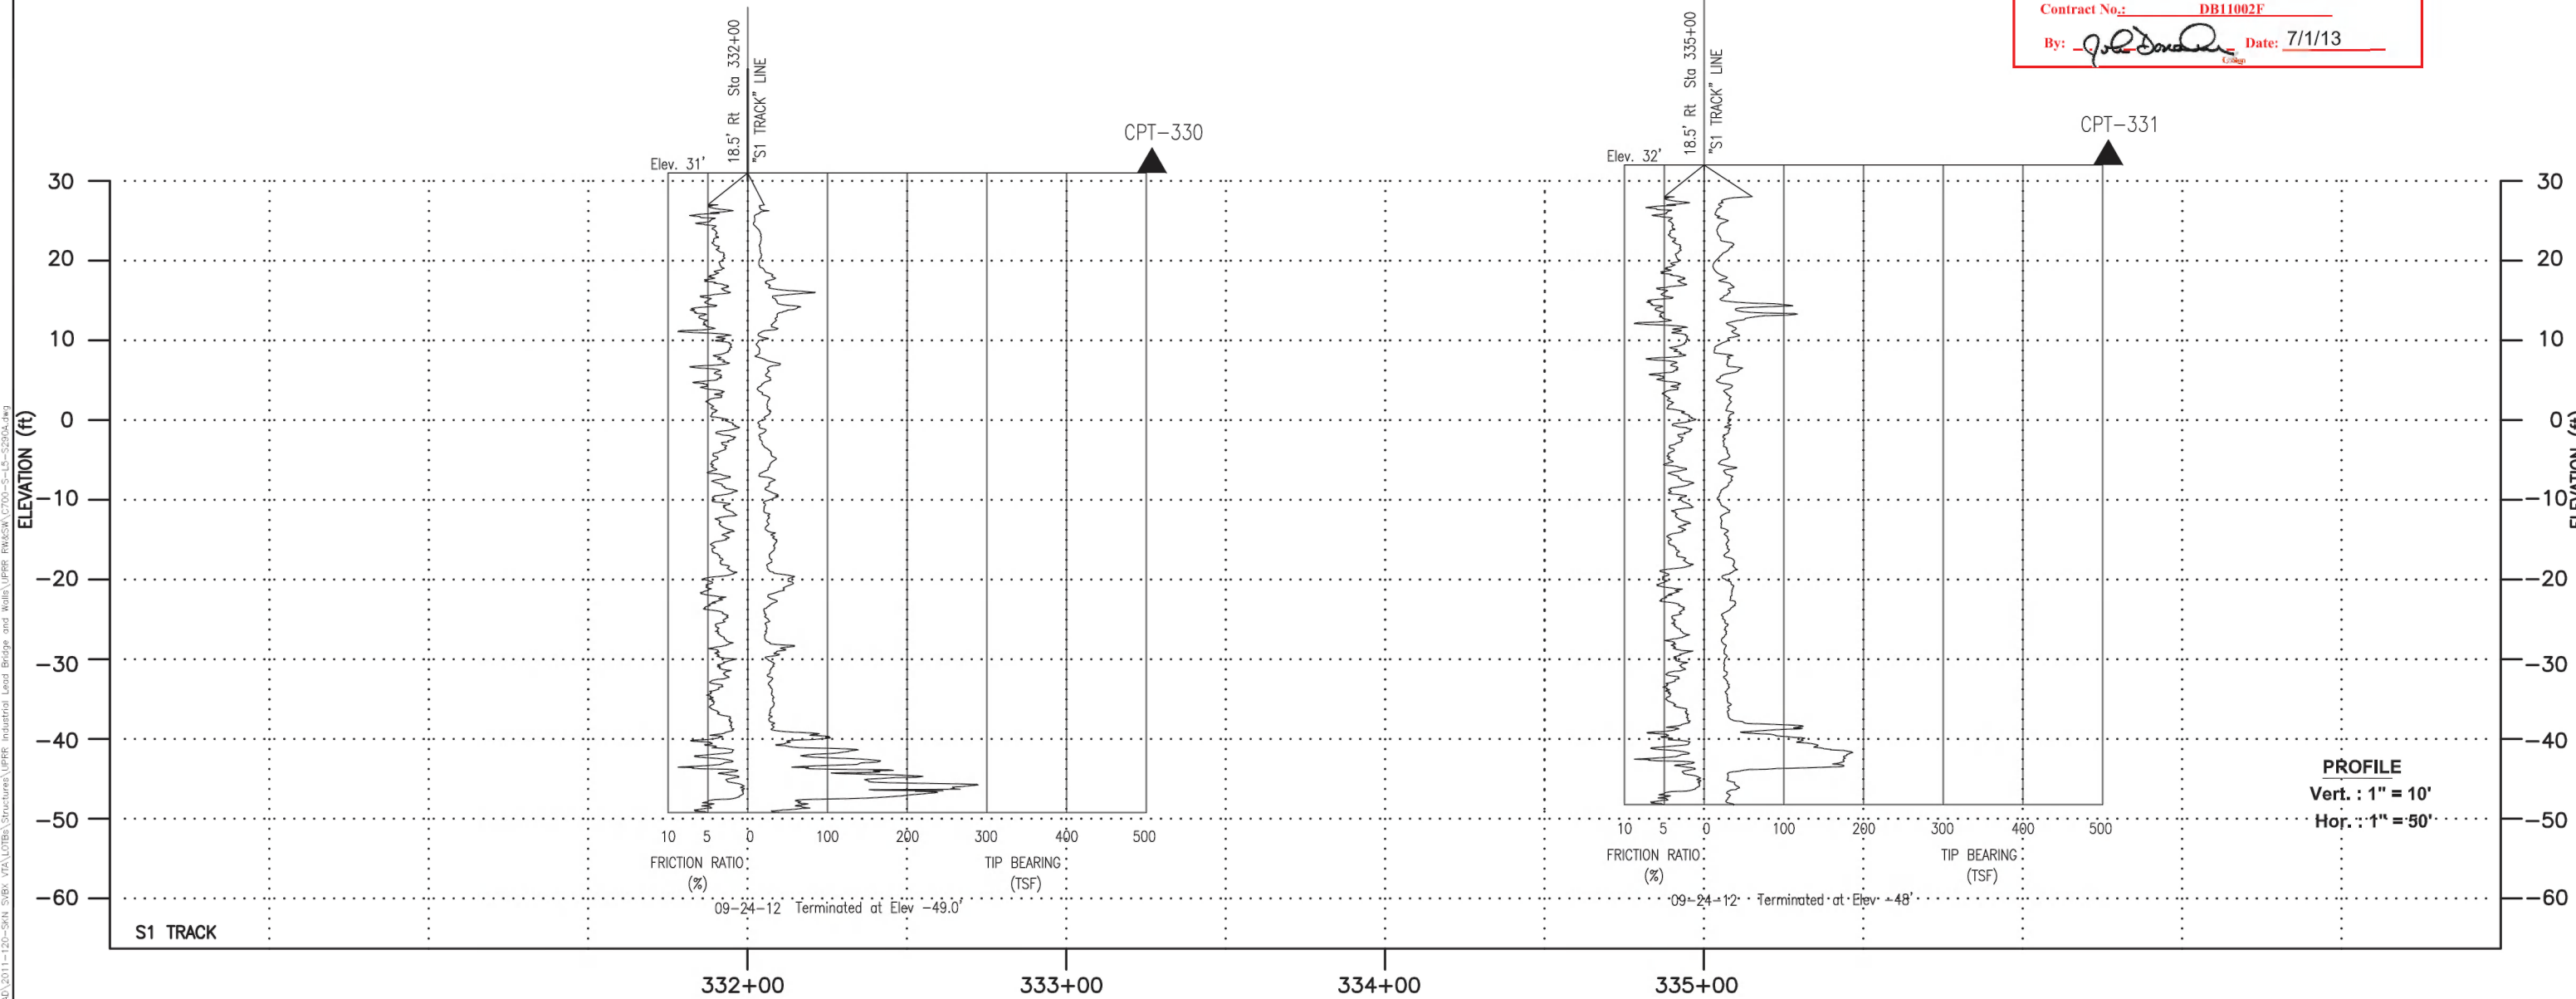

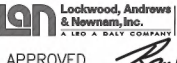0 20121102				READY FOR CONSTRUCTION				DESIGNED BY O. GOUIER DRAWN BY O. GOUIER CHECKED BY F. WANG IN CHARGE G. PARIKH DATE 20121102								Skanska Shimmick Herzog 1436 California Circle Milpitas, California 95035 A Joint Venture				 Lockwood, Andrews & Newnam, Inc. A JOINT VENTURE  T.Y. LIN INTERNATIONAL								LINE, TRACK, STATIONS AND SYSTEMS UPRR RETAINING WALLS/SOUND WALLS LOG OF TEST BORINGS 6 OF 6				CADD FILENAME C700-S-L5-S290A.dwg SIZE SCALE D AS NOTED CONTRACT NO. C700 REV. 0 AREA CODE L5 SHEET NO. S290A PAGE NO. 0023			
-----------------------	--	--	--	-----------------------------------	--	--	--	--	--	--	--	---	--	--	--	---	--	--	--	---	--	--	--	--	--	--	--	--	--	--	--	--	--	--	--

SCALE: AS NOTED

2. ALL DIMENSIONS ARE IN FEET UNLESS OTHERWISE SHOWN



VERT. : 1" = 10'
HOR. : 1" = 40'

--	--	
EART SILICON VALLEY BERRYESSA EXTENSION

REFERENCE DRAWING

VTA CONTRACT NO: C700

ISSUE:

DATE: 2012.10.2

VTA FILENAME: C700-S-L5-S292A.pdf

VTA DWG NO: L5-S292A REV: 0


CONTRACT PAGE NO: 0025

SCALE: AS NOTED

NOTES:

1. STANDARD PENETRATION TEST SAMPLER: I.D. = 1.4", O.D. = 2"
MODIFIED CALIFORNIA SAMPLER: I.D. = 2.5"; O.D. = 3"
HAMMER ASSEMBLY: A 140 LB HAMMER WITH A 30" DROP
(ROPE AND PULLEY)

2. ALL DIMENSIONS ARE IN FEET UNLESS OTHERWISE SHOWN

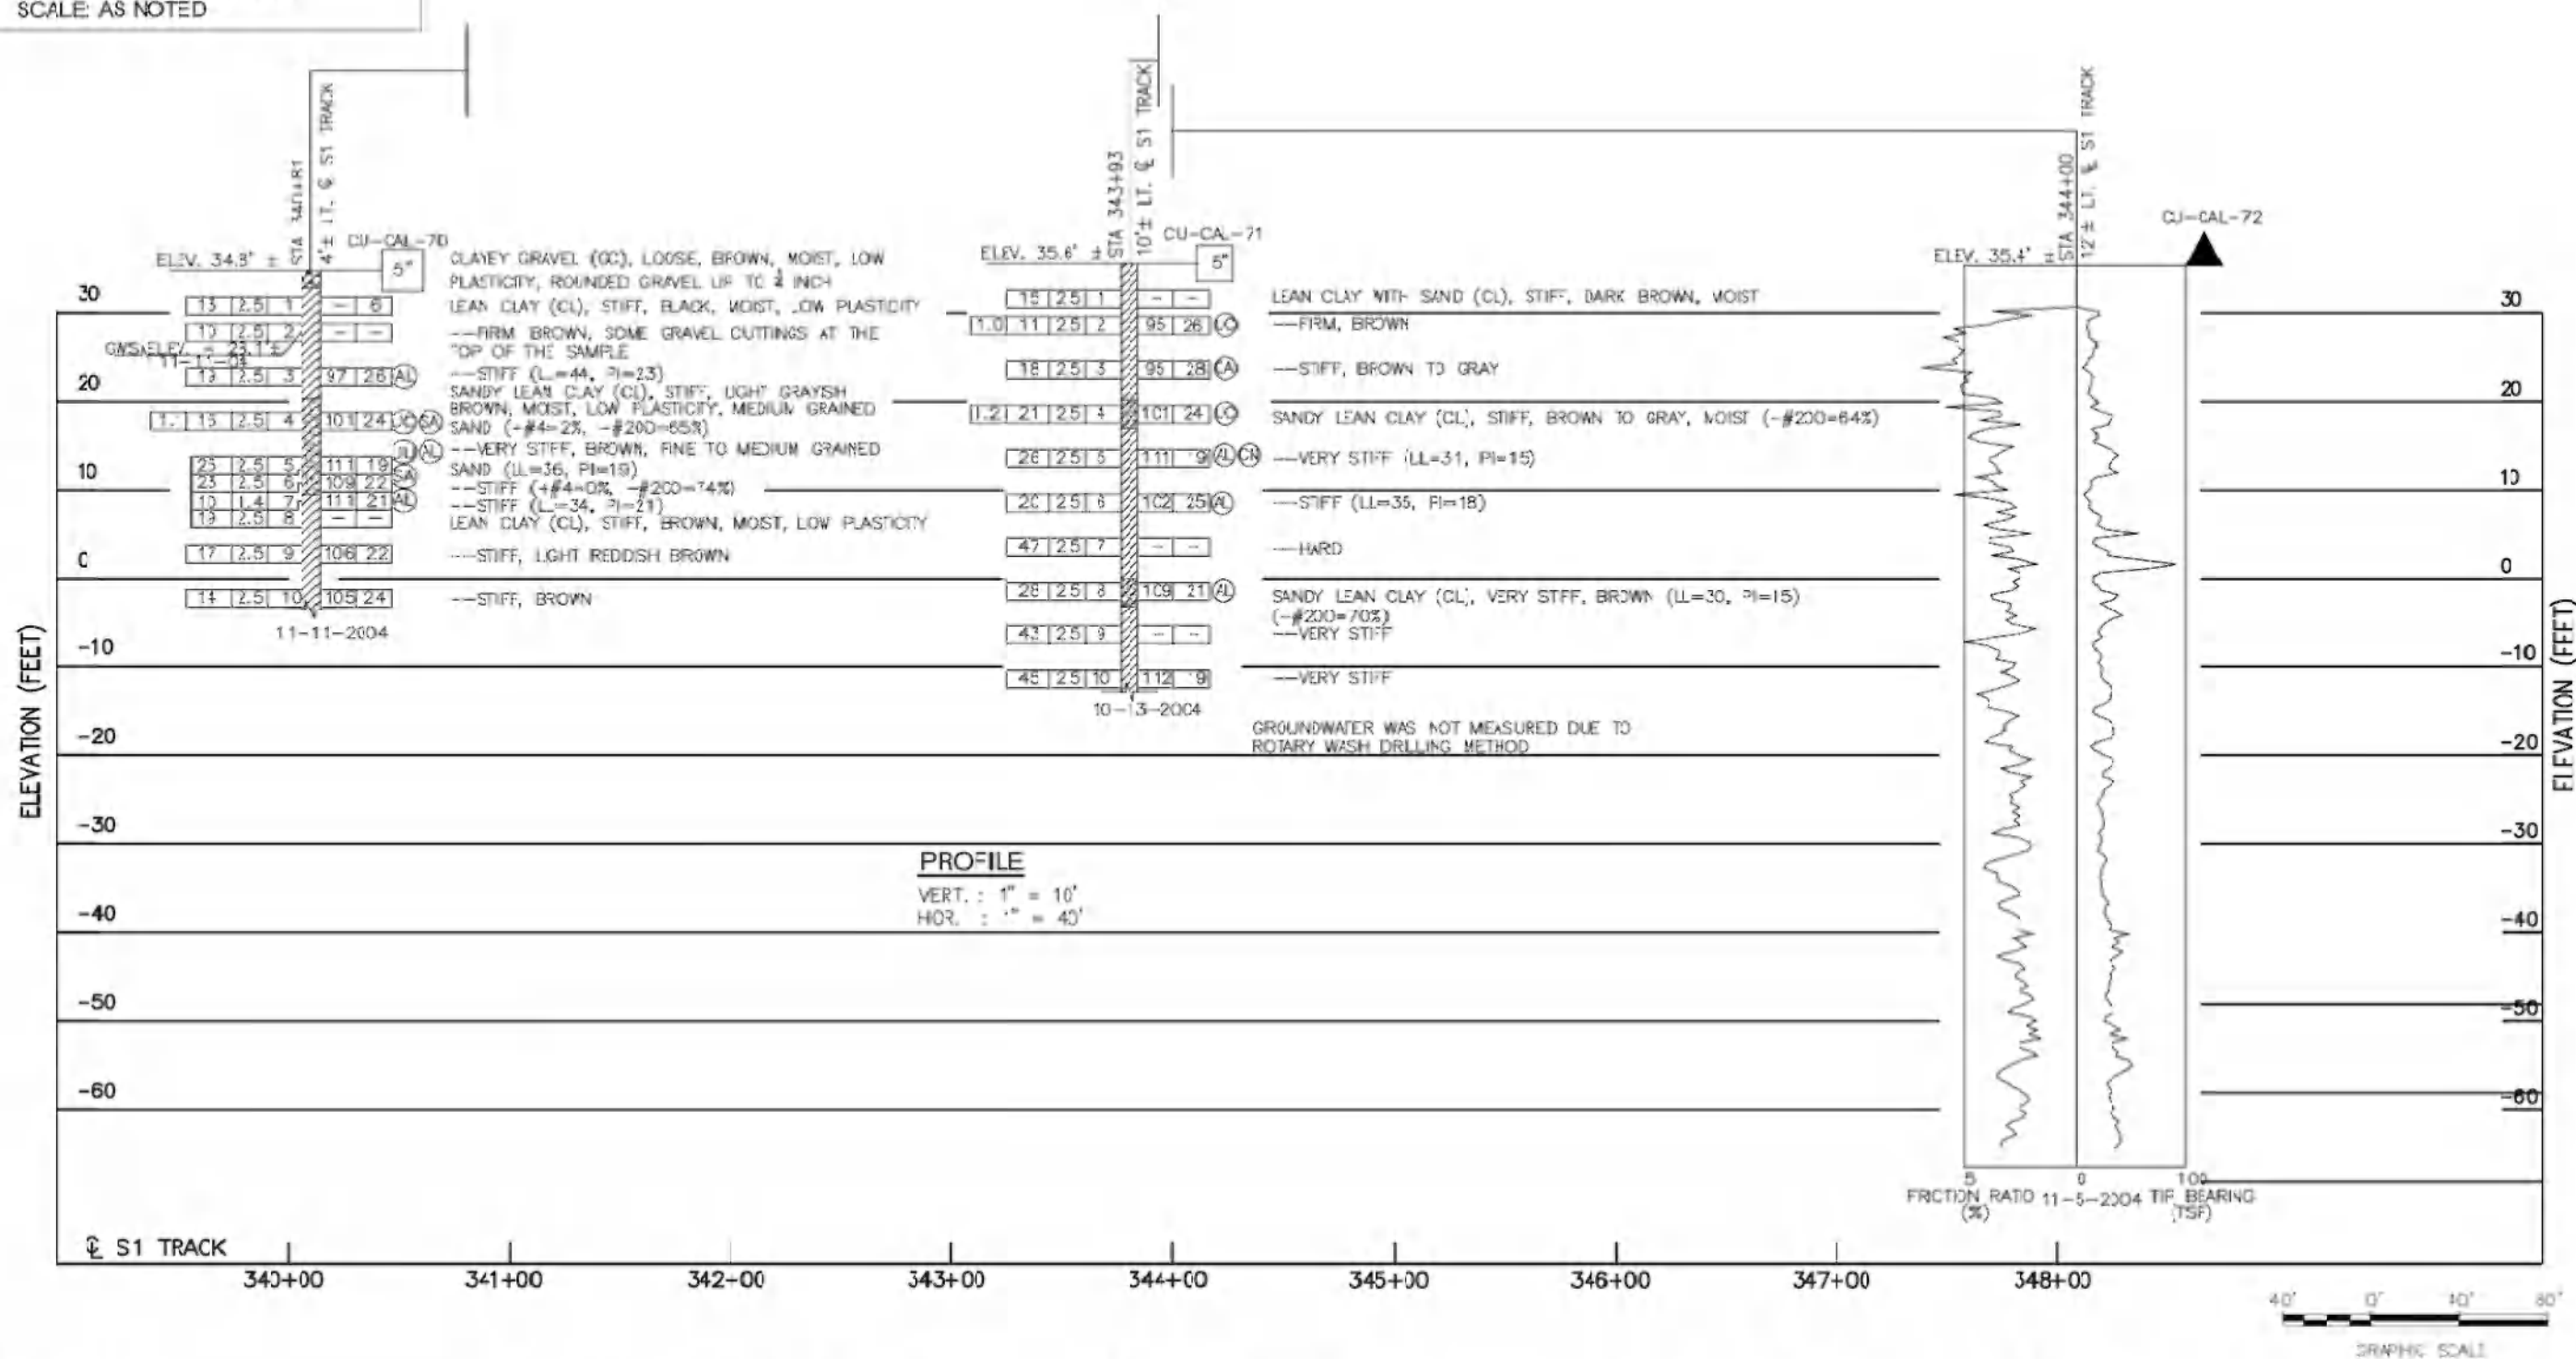

File 11, 2011 - 11:25am C:\pwworking\hntb\proj\hntb\BART-S-L5-S292A.dwg

DESIGNED BY	L. RAN
DRAWN BY	L. RAN
CHECKED BY	D. NANG
IN CHARGE	G. PARKH
DATE	

RECEIVED PROFESSIONAL ENGINEER
STATE OF CALIFORNIA



PARKH CONSULTANTS, INC.
2360 DUME DRIVE, SUITE A
SAN JOSE, CA 95131
SUBMITTED

HNTB
HNTB Corporation
Engineers Architects Planners
1775 Technology Drive Suite 400
San Jose, CA 95128-1000
APPROVED

NOT FOR CONSTRUCTION



LINE, TRACK, STATIONS AND SYSTEMS
TRACKWAY
LOG OF TEST BORINGS
SHEET 2 OF 17
CDD FILENAME: C700-S-L5-S292A.dwg
SHEET NO: 1
SCALE: 1"=40'H; 1"=10'V
CONTRACT NO: C700
AREA CODE: MI
SHEET NO: X502
PAGE NO: P

SCALE: AS NOTED

2. ALL DIMENSIONS ARE IN FEET UNLESS OTHERWISE SHOWN

[illegible]


EART SILICON VALLEY BERRYESSA EXTENSION

REFERENCE DRAWING

VTA CONTRACT NO: C700
 ISSUE:
 DATE: 2012.102
 VTA FILENAME: C700-S-L5-S294A.pdf
 VTA DWG NO: L5-S294A REV: C
 CONTRACT PAGE NO: 0027
 SCALE: AS NOTED

NOTES:

- STANDARD PENETRATION TEST SAMPLER: I.D. = 1.4"; O.D. = 2"
 MODIFIED CALIFORNIA SAMPLER: I.D. = 2.5"; O.D. = 3"
 HAMMER ASSEMBLY: A 140 LB HAMMER WITH A 33" DROP
 (ROPE AND PULLEY)
- ALL DIMENSIONS ARE IN FEET UNLESS OTHERWISE SHOWN

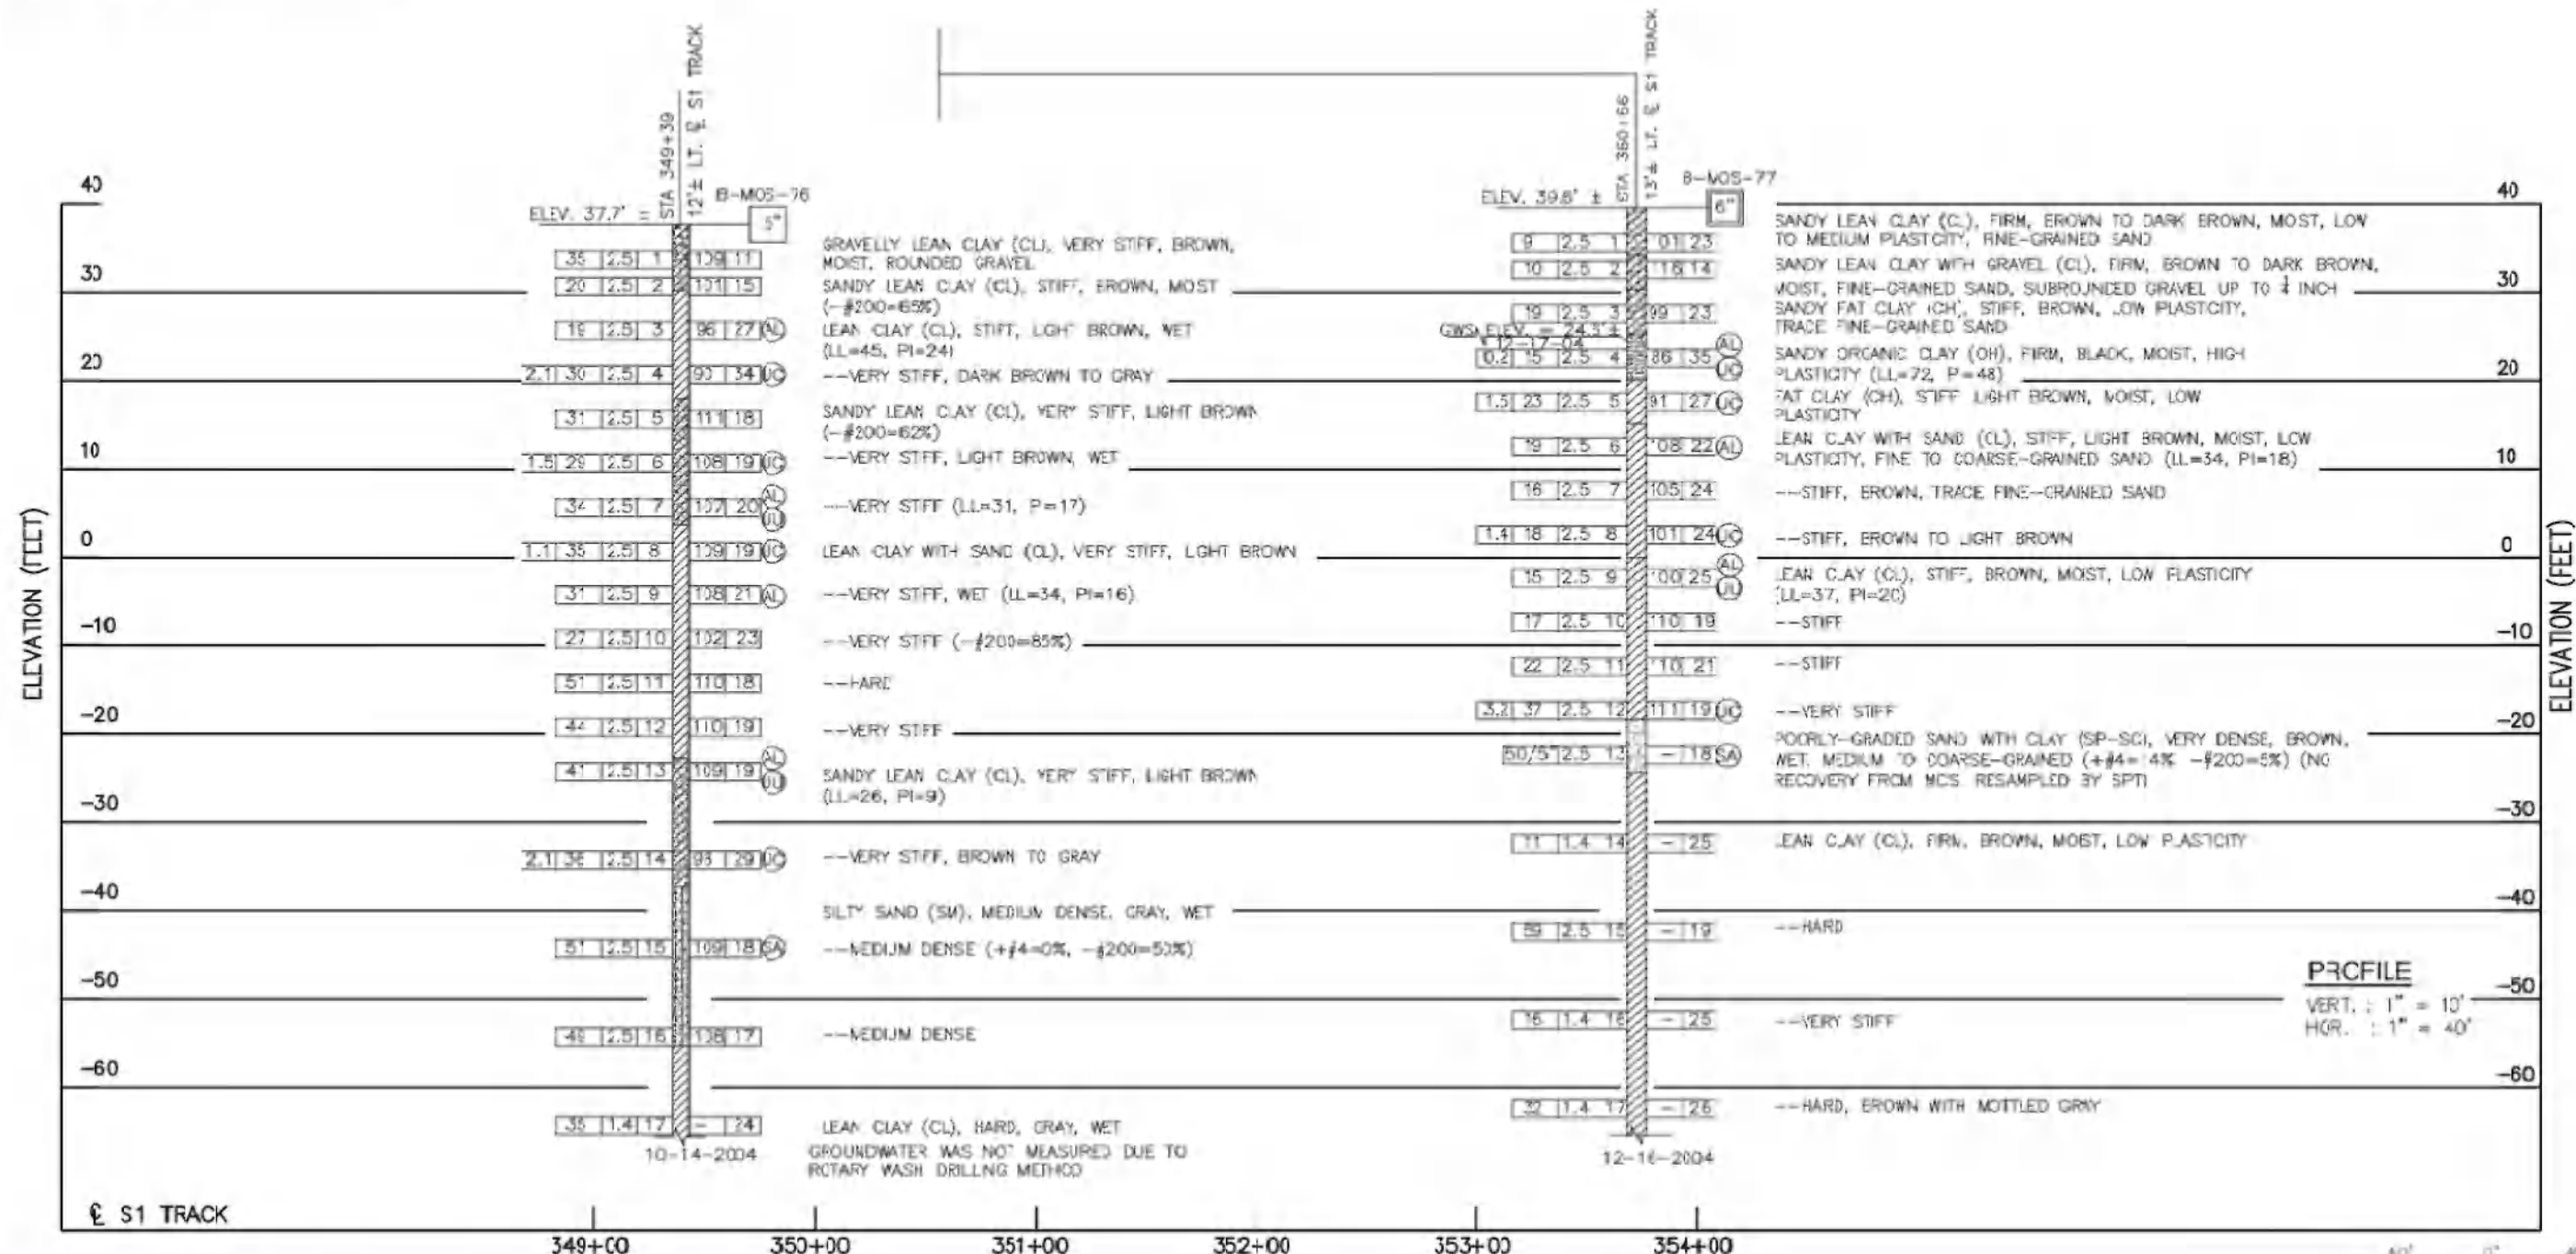

11/11/2011 11:25:00 AM C:\Users\jgarcia\Documents\BART\Silicon Valley\BERRYESSA EXTENSION\BERRYESSA EXTENSION.dwg
 11/11/2011 11:25:00 AM C:\Users\jgarcia\Documents\BART\Silicon Valley\BERRYESSA EXTENSION\BERRYESSA EXTENSION.dwg
 11/11/2011 11:25:00 AM C:\Users\jgarcia\Documents\BART\Silicon Valley\BERRYESSA EXTENSION\BERRYESSA EXTENSION.dwg

REV	DATE	BY	SUB	APP	DESCRIPTION
P	20110311				REQUEST FOR PROPOSAL

DESIGNED BY
 L. TRAN
 DRAWN BY
 L. TRAN
 CHECKED BY
 D. WANG
 IN CHARGE
 G. PARKH
 DATE



PARKH CONSULTANTS, INC.
 2360 CUME DRIVE, SUITE A
 SAN JOSE, CA 95131
 SUBMITTED

HNTB
 HNTB Corporation
 Engineers Architects Planners
 1111 First Street, Suite 400
 San Jose, CA 95131
 APPROVED

NOT FOR
 CONSTRUCTION




LINE, TRACK, STATIONS AND SYSTEMS
 TRACKWAY
 LOG OF TEST BORINGS
 SHEET 4 OF 17

CDD FILENAME C700-S-L5-S294A.dwg	REV P
SIZE D 1"=40'H; 1"=10'V	CONTRACT NO. C700
AREA CODE MI	SHEET NO. X504
PAGE NO.	

SCALE: AS NOTED

2. ALL DIMENSIONS ARE IN FEET UNLESS OTHERWISE SHOWN

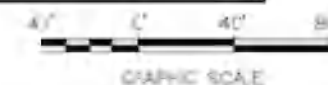

CADD FILENAME C700-S-#1-X505.dwg	
SIZE D	SCALE 1"=40'H; 1"=10V
CONTRACT NO.	REV
AREA CODE M1	SHEET NO. X505

SCALE: AS NOTED

2. ALL DIMENSIONS ARE IN FEET UNLESS OTHERWISE SHOWN



Feb 11, 2011					DESIGNED BY L. PARK DRAWN BY L. PARK CHECKED BY D. WANG IN CHARGE G. PARKH DATE					 PARKH CONSULTANTS, INC. 1360 QUINN DRIVE, SUITE A SAN JOSE, CA 95131					 HNTB Corporation Engineers Architects Planners 1715 Technology Drive, Suite 400 San Jose, CA 95128-1528					NOT FOR CONSTRUCTION					 BART SILICON VALLEY BERRYESSA EXTENSION					LINE, TRACK, STATIONS AND SYSTEMS TRACKWAY LOG OF TEST BORINGS SHEET 6 OF 17					CDD FILENAME C700-S-d1-X506.dwg SIZE D 1"=40'H; 1"=10'V CONTRACT NO. C700 REV P AREA CODE MI SHEET NO. X506 PAGE NO																																																																																																																																																																																																																																																																																																																																																																																																																																																																																																																																																																																																																																																																																																																																																																																																																																																																																																																																																																																																																																																																																																																																																																																																																																																																																																																																																																																																																																																																																																																																																																																																																																																																																																																																																																																																																																																																																																																																																																																																																																																																																																																																																																																																																																																																																																																																																																																																																																																																																																																																																																																																																																																																																																																																																																																																																																																																																																																																																																																																																																																																																																																												
P 20110311					REQUEST FOR PROPOSAL																																																																																																																																																																																																																																																																																																																																																																																																																																																																																																																																																																																																																																																																																																																																																																																																																																																																																																																																																																																																																																																																																																																																																																																																																																																																																																																																																																																																																																																																																																																																																																																																																																																																																																																																																																																																																																																																																																																																																																																																																																																																																																																																																																																																																																																																																																																																																																																																																																																																																																																																																																																																																																																																																																																																																																																																																																																																																																																																																																																																																																																																																																																																																						</				

EART SILICON VALLEY BERRYESSA EXTENSION

REFERENCE DRAWING

VTa CONTRACT NO: C700

ISSUE:

DATE: 2012.102

VTa FILENAME: C700-S-L5-S297A.pdf

VTa DWG NO: L5-S297A REV: 0


CONTRACT PAGE NO: 0030

SCALE: AS NOTED

NOTES:

1. STANDARD PENETRATION TEST SAMPLER: I.D. = 1.4"; O.D. = 2"
MODIFIED CALIFORNIA SAMPLER: I.C. = 2.5"; O.D. = 3"
HAMMER ASSEMBLY: A 140 LB HAMMER WITH A 30" DROP
(ROPE AND PULLEY)


2. ALL DIMENSIONS ARE IN FEET UNLESS OTHERWISE SHOWN

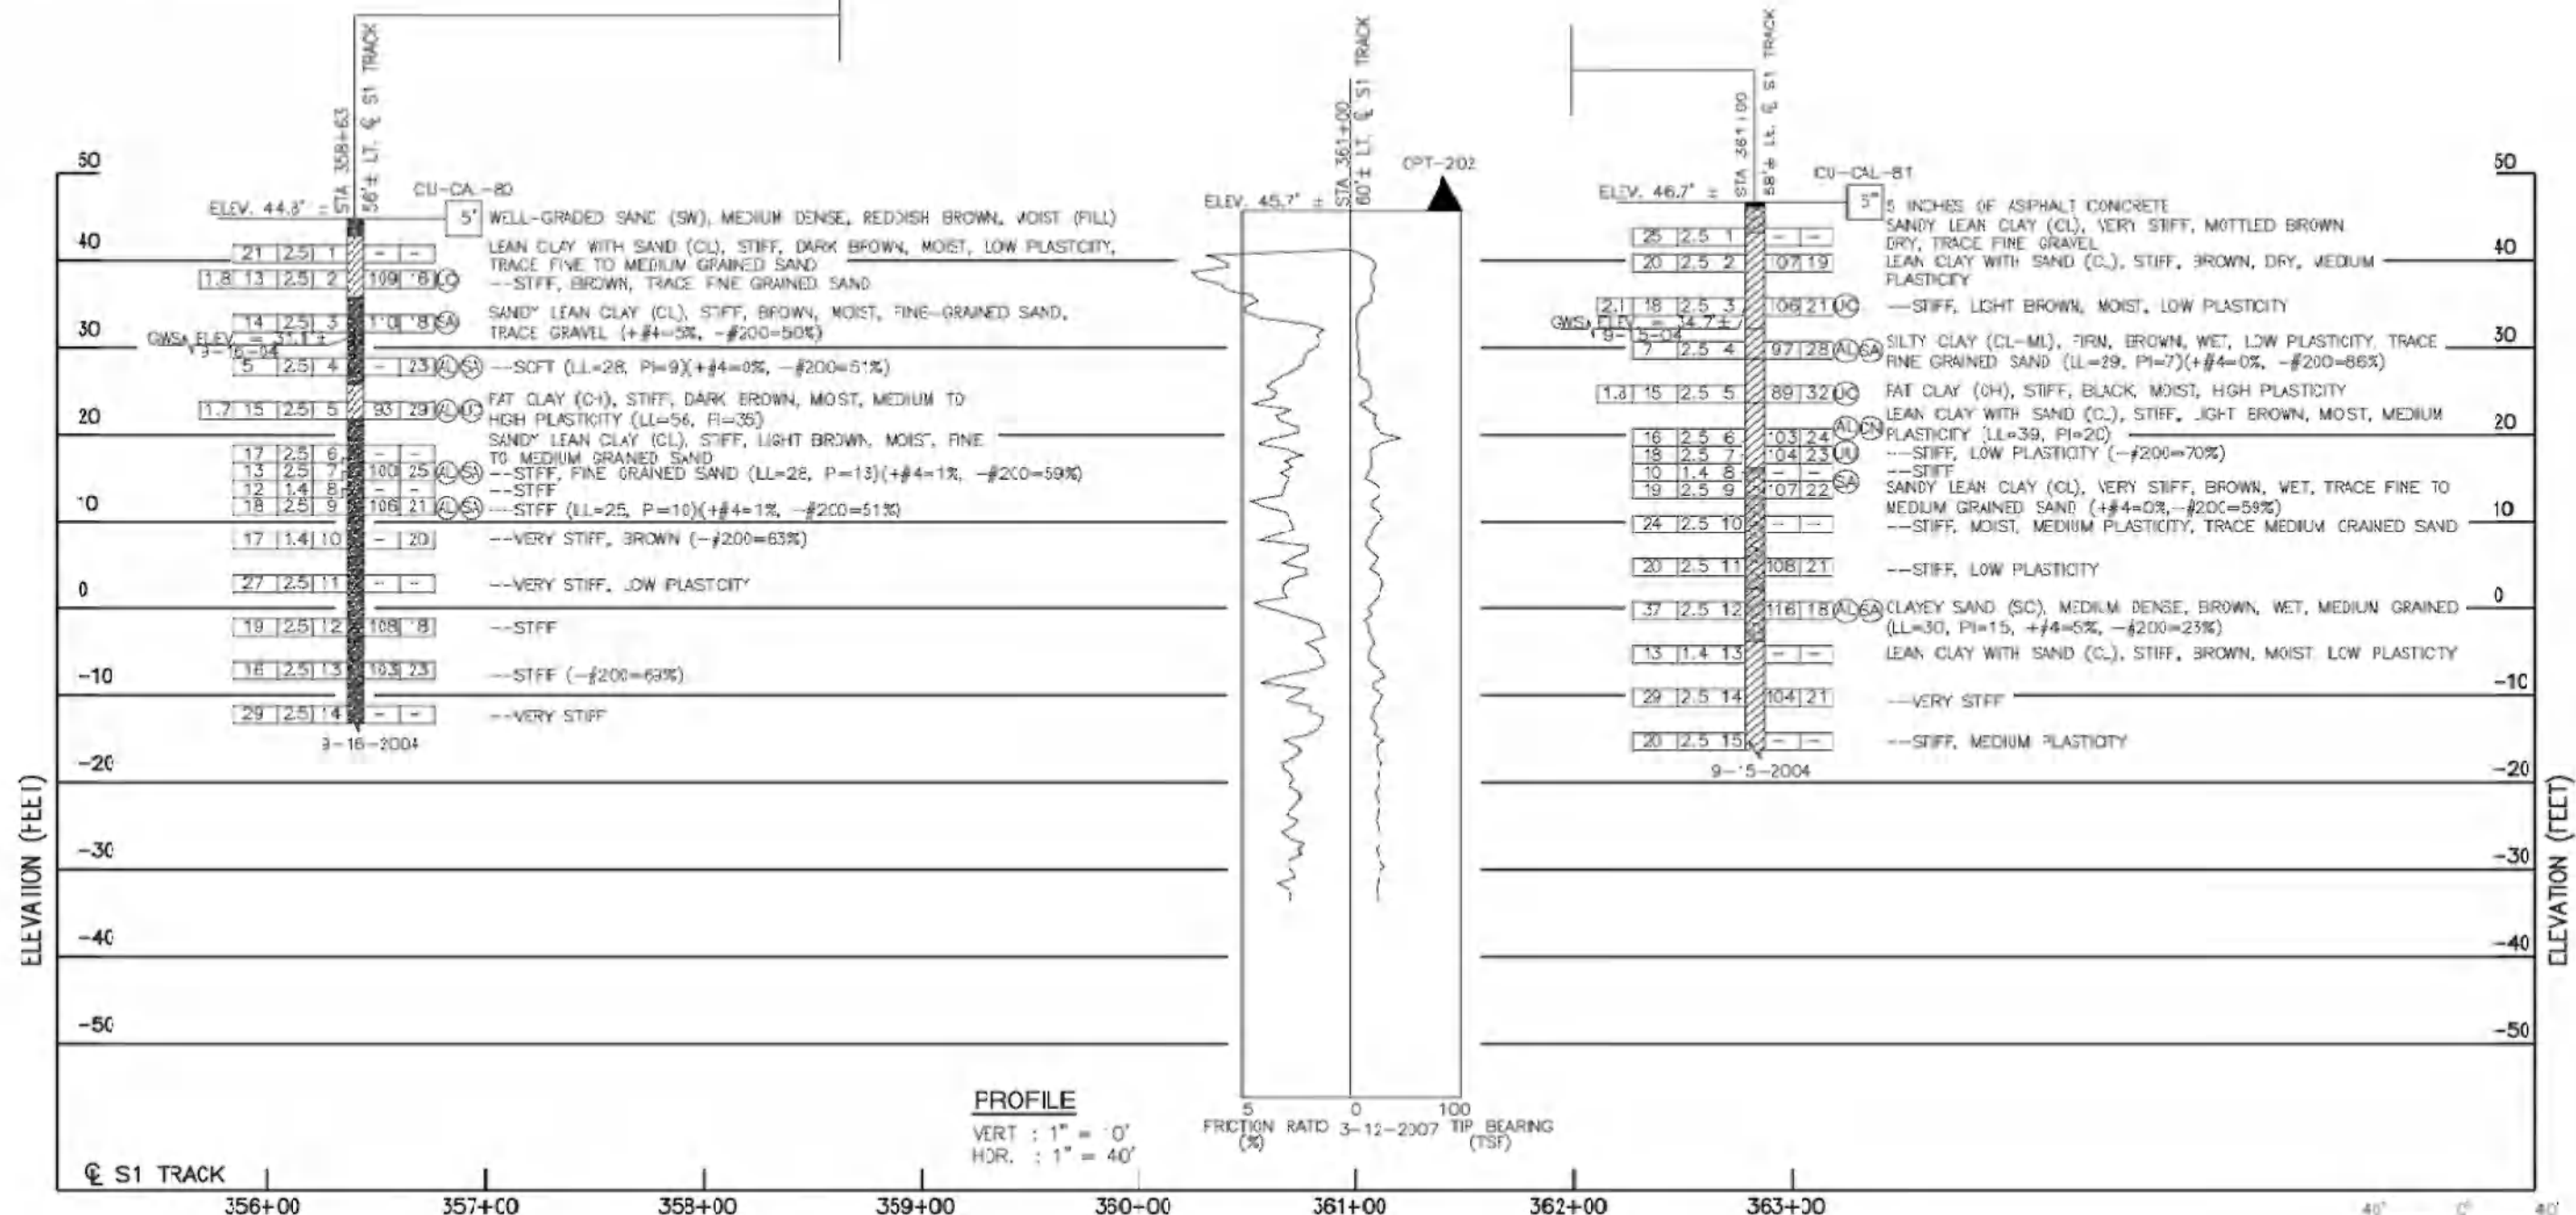

Feb 11, 2011 11:45am C:\pwworking\hntb\proj\BART-SV\BERRYESSA\EXT\DWG\0030.dwg

DESIGNED BY	L. RAN
DRAWN BY	L. RAN
CHECKED BY	D. WANG
IN CHARGE	G. PARKH
DATE	

REGISTERED PROFESSIONAL ENGINEER	STATE OF CALIFORNIA
NO. 00000000	00000000

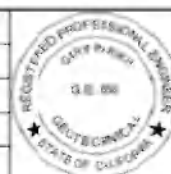

PARKH CONSULTANTS, INC.	1360 DUME DRIVE, SUITE A SAN JOSE, CA 95131
SUBMITTED	

HNTB	HNTB Corporation Engineers Architects Planners
1775 Technology Drive Suite 400 San Jose, CA 95128-1028	
APPROVED	

NOT FOR CONSTRUCTION



LINE, TRACK, STATIONS AND SYSTEMS	TRACKWAY LOG OF TEST BORINGS SHEET 7 OF 17
CDD FILENAME C700-S-L5-S297A.dwg	REVISION P
SCALE 1"=40'H; 1"=10'V	CONTRACT NO. C700
AREA CODE MI	SHEET NO. X507
PAGE NO.	

EART SILICON VALLEY BERRYESSA EXTENSION

REFERENCE DRAWING

VTA CONTRACT NO: C700

ISSUE:

DATE: 2012.102

VTA FILENAME: C700-S-L5-S298A.pdf


VTA DWG NO: L5-S298A REV. C

CONTRACT PAGE NO: 0031

SCALE: AS NOTED

NOTES:

1. STANDARD PENETRATION TEST SAMPLER: I.D. = 1.4"; O.D. = 2"
MODIFIED CALIFORNIA SAMPLER: I.D. = 2.5"; O.D. = 3"
HAMMER ASSEMBLY: A 140 LB HAMMER WITH A 30" DROP
(ROPE AND PULLEY)
2. ALL DIMENSIONS ARE IN FEET UNLESS OTHERWISE SHOWN

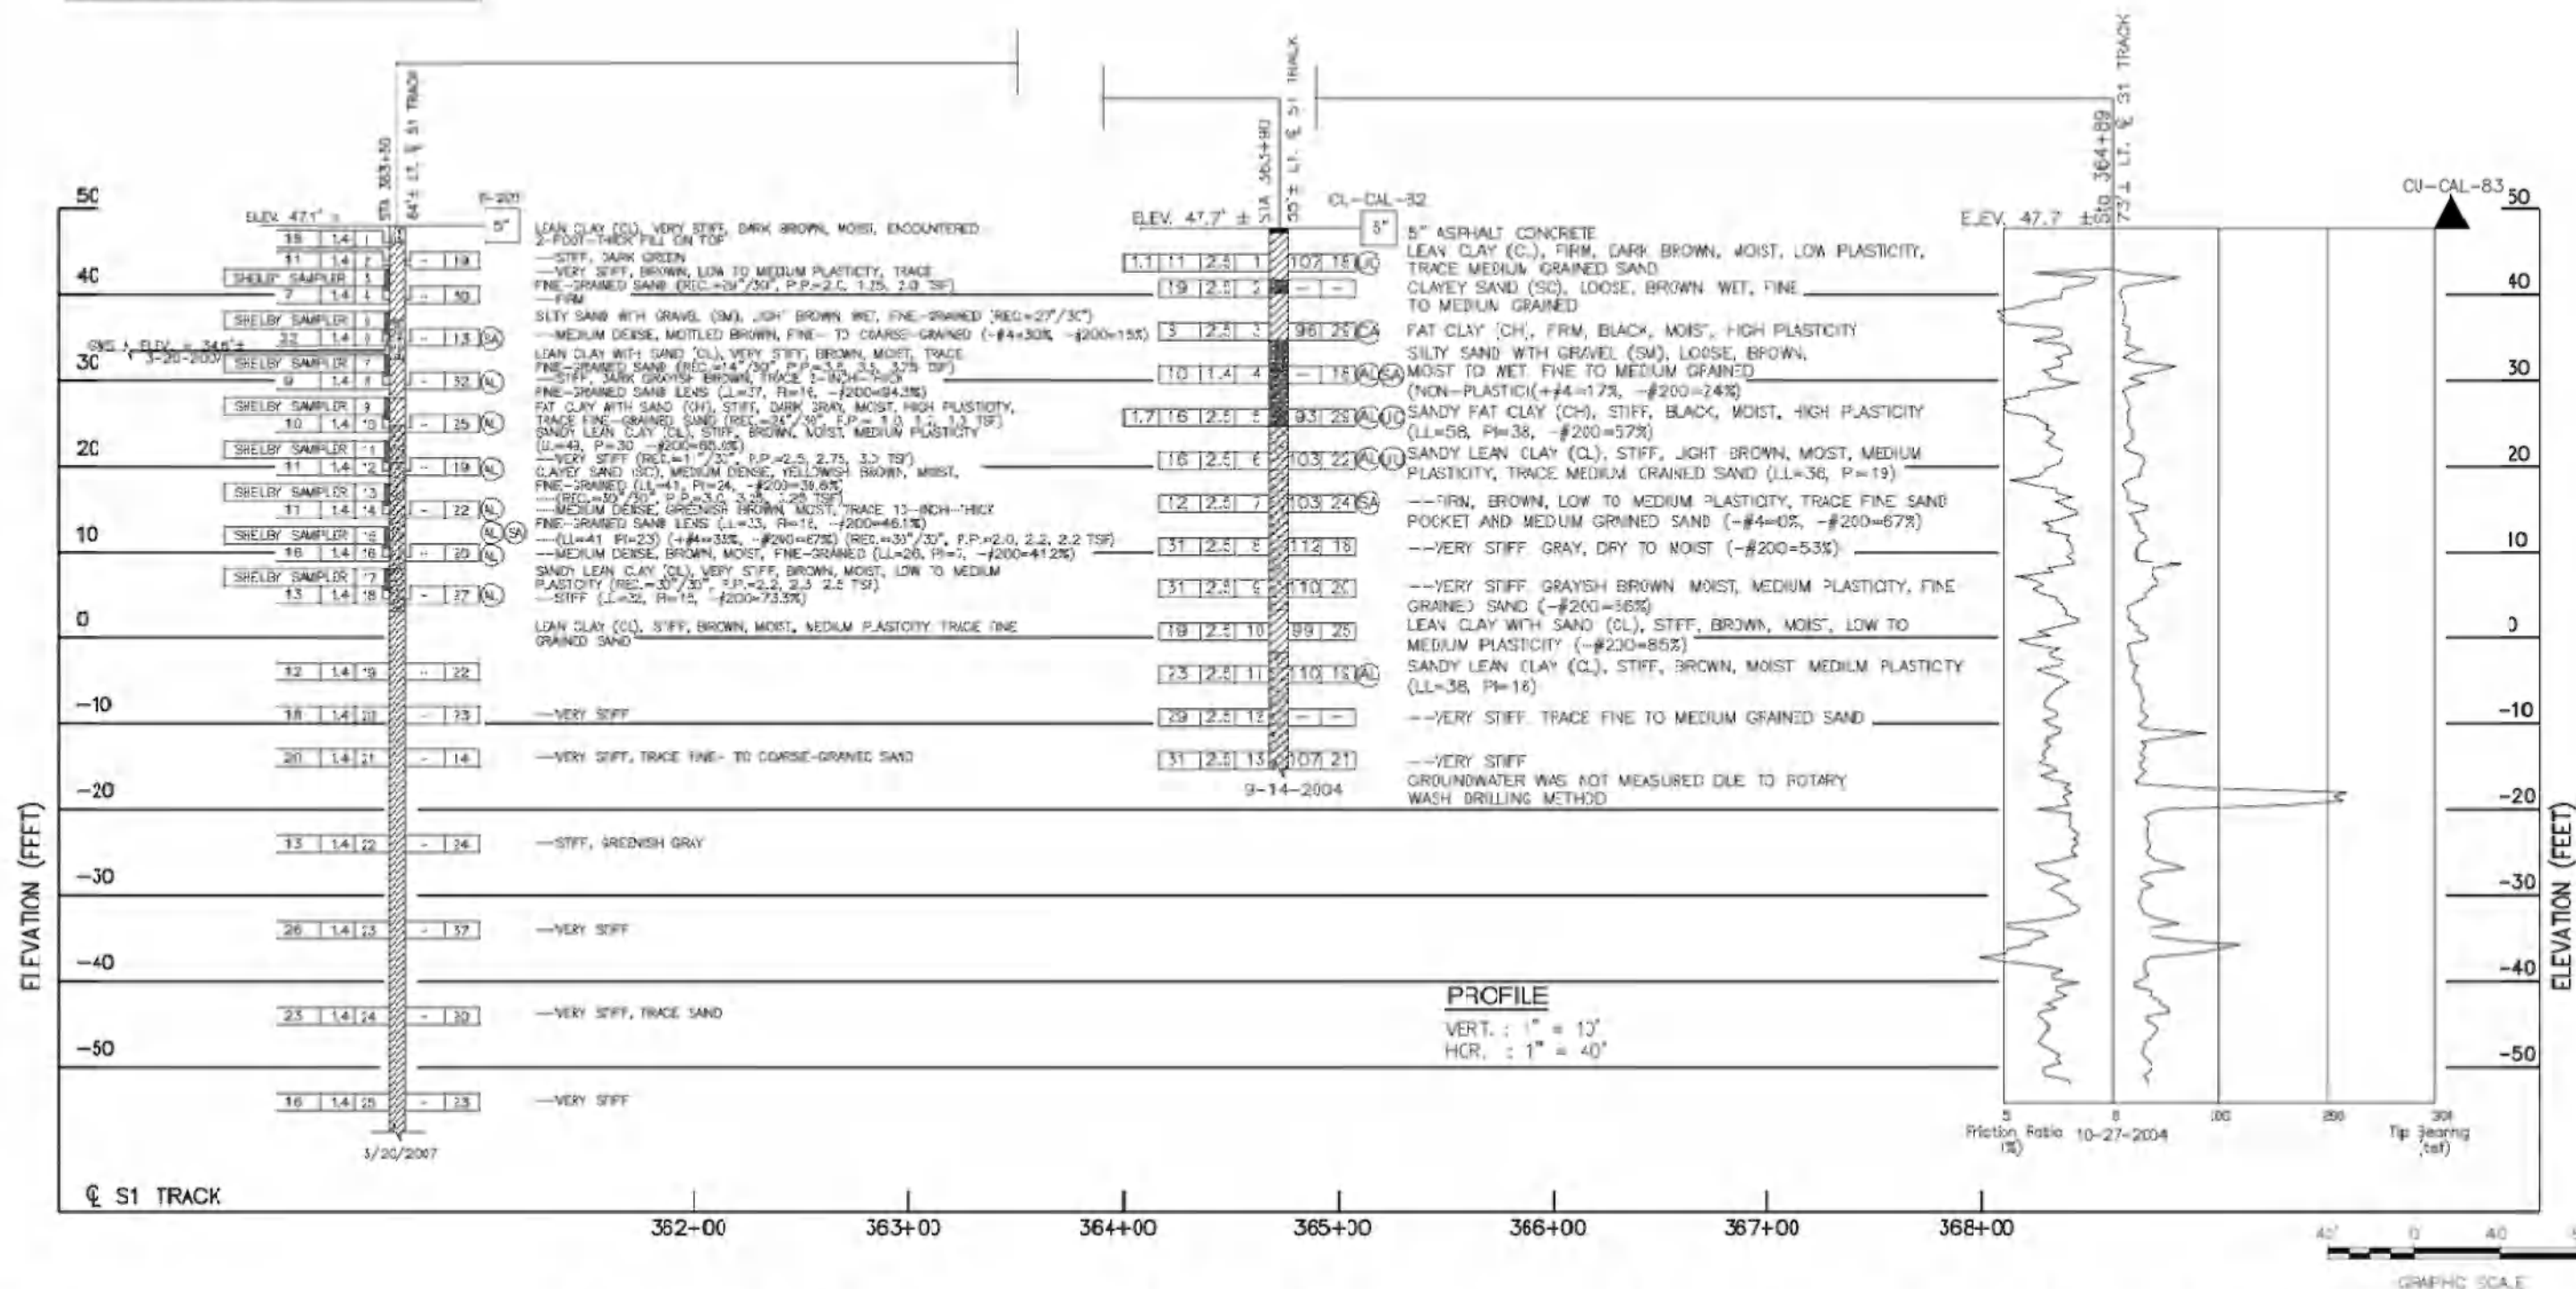

File 11, 2011 - 11:45am C:\pwworking\hntb\proj\BART-Silicon Valley\BERRYESSA EXTENSION\DWG\0031.dwg

REV	DATE	BY	CHK	APP	DESCRIPTION
P	20110311				REQUEST FOR PROPOSAL

DESIGNED BY
L. TRAN
DRAWN BY
L. TRAN
CHECKED BY
D. WANG
IN CHARGE
G. PARKH
DATE



PARKH CONSULTANTS, INC.
1360 CUME DRIVE, SUITE A
SAN JOSE, CA 95131

HNTB HNTB Corporation
Engineers Architects Planners
1715 Foothill Express Suite 400
San Jose, CA 95128-1000

NOT FOR
CONSTRUCTION



LINE, TRACK, STATIONS AND SYSTEMS			
TRACKWAY LOG OF TEST BORINGS SHEET 8 OF 17			
CDD FILENAME C700-S-41-X508.dwg	SIZE SCALE D 1"=40'H; 1"=10'V	CONTRACT NO. C700	REV P
AREA CODE MI	SHEET NO. X508	PAGE NO.	